

Cantilever A Pier 6 North Face

- See photos 1 and 2.
- 1" diameter remaining at base of steel rod (original 1 3/8" diameter based on 1967 record plans) (See Photo 1).
- Defect to cause failure of tiedown not found, however, it was observed a gap between cantilever end and beam seat (fit 11" long section of clipboard in gap), bouncing of cantilever end and tiedown under live load. It is assumed based on the observations that the tiedown has failed with the failure location not visible. (See Photos 1 and 2)

Cantilever A Pier 7 North Face


- See photos 3-5.
- Tiedown steel rod failed, sheared at the top below deck (See Photos 3-5)

Cantilever F Pier 6 South Face

- See photos 6 and 7.
- 1" diameter remaining at base of steel rod (original 1 3/8" diameter based on 1967 record plans) (See Photos 6 and 7).

Cantilever F Pier 7 South Face

- See photos 8 and 9.
- Tiedown steel rod failed, sheared at the base near the seat (See Photos 8)
- Gap between cantilever end and seat up to 8" long (See Photo 9)


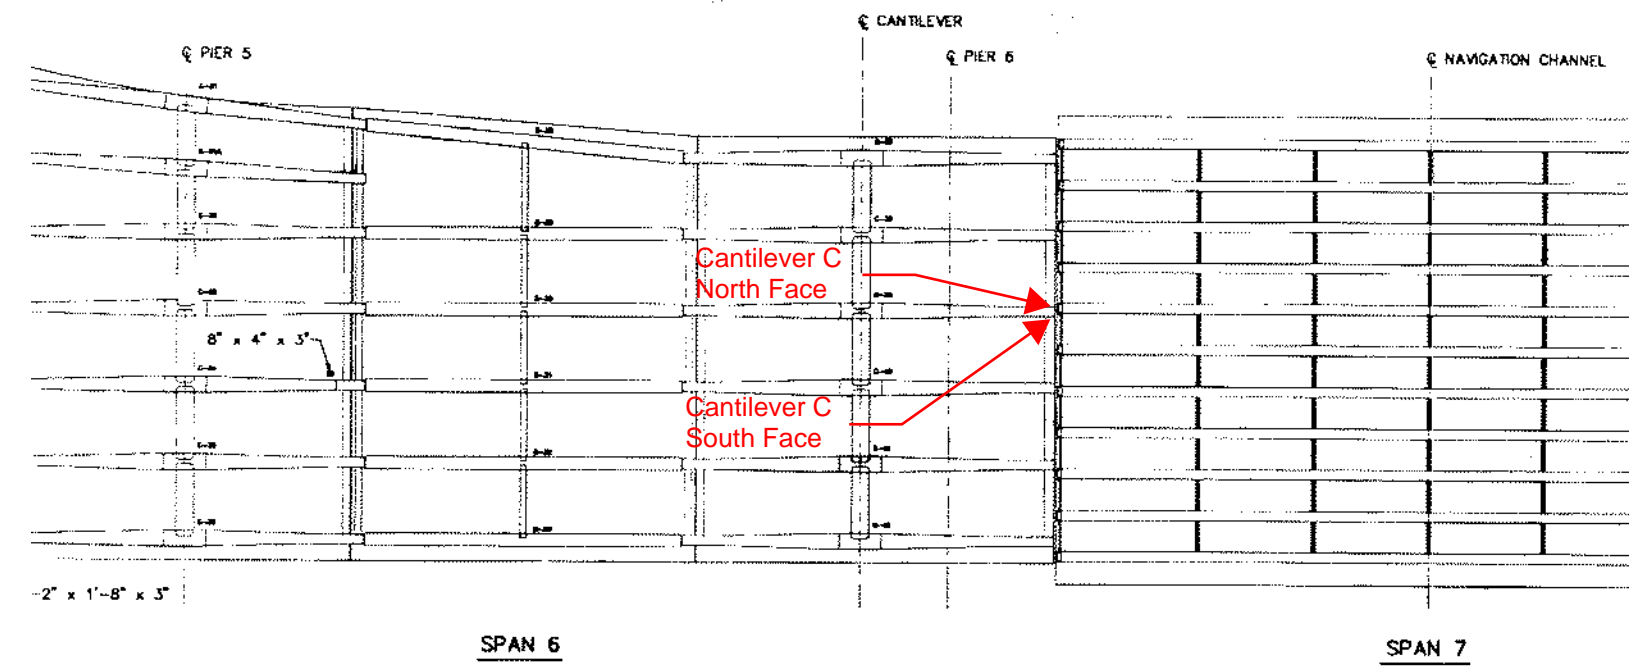


Cantilever C North Face



Cantilever C South Face

Note:  
 - Spalls on diaphragm at Cantilever C north and south face. Rust stain on the Bay B diaphragm at approximate tie down steel rod location, and exposed steel rod at Bay diaphragm.

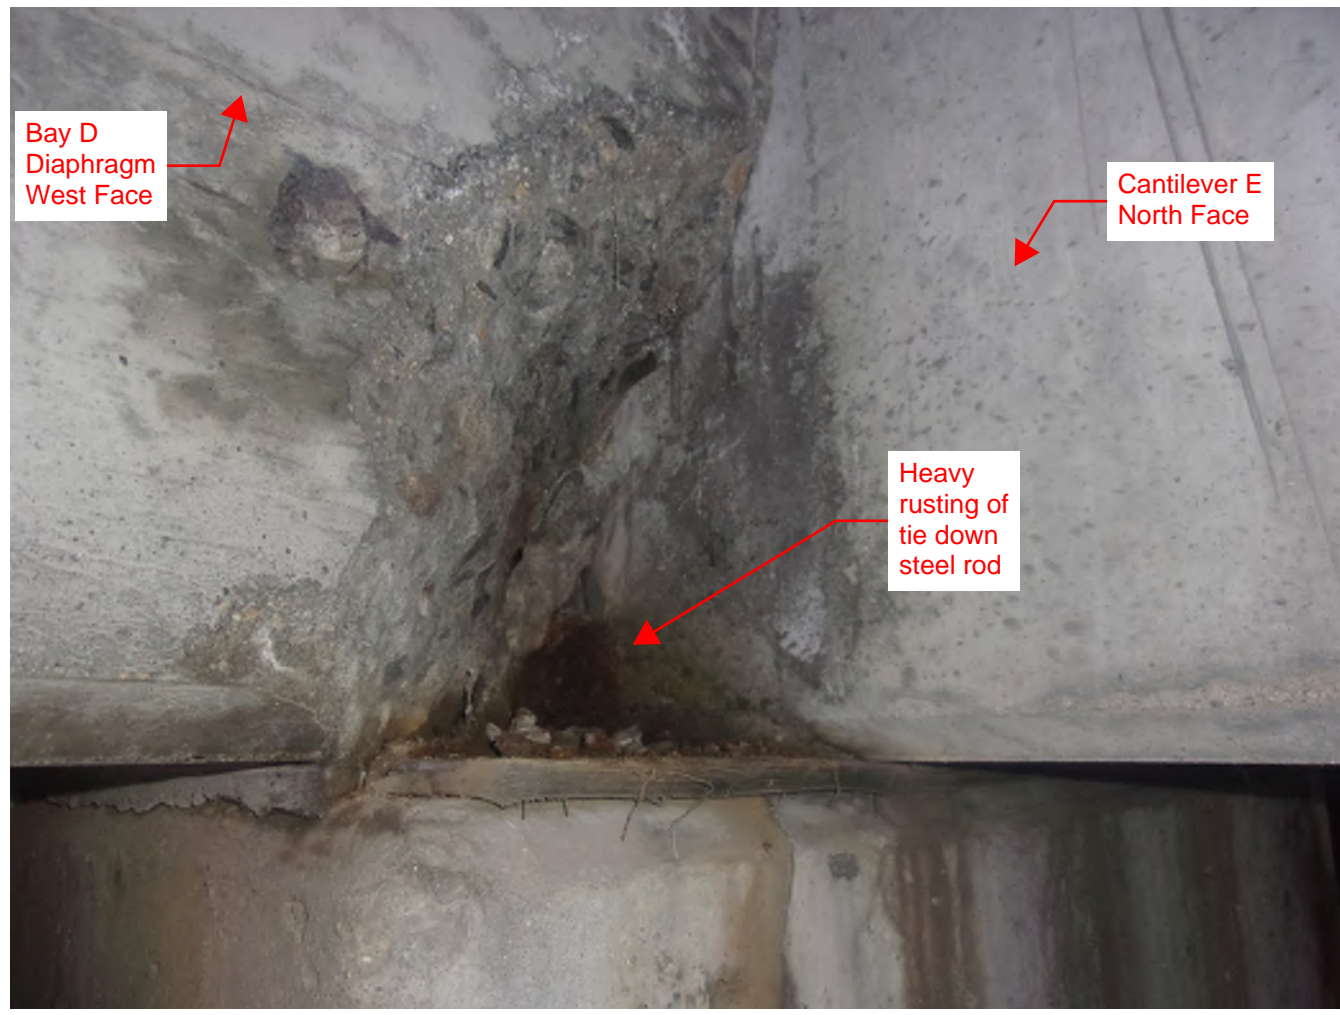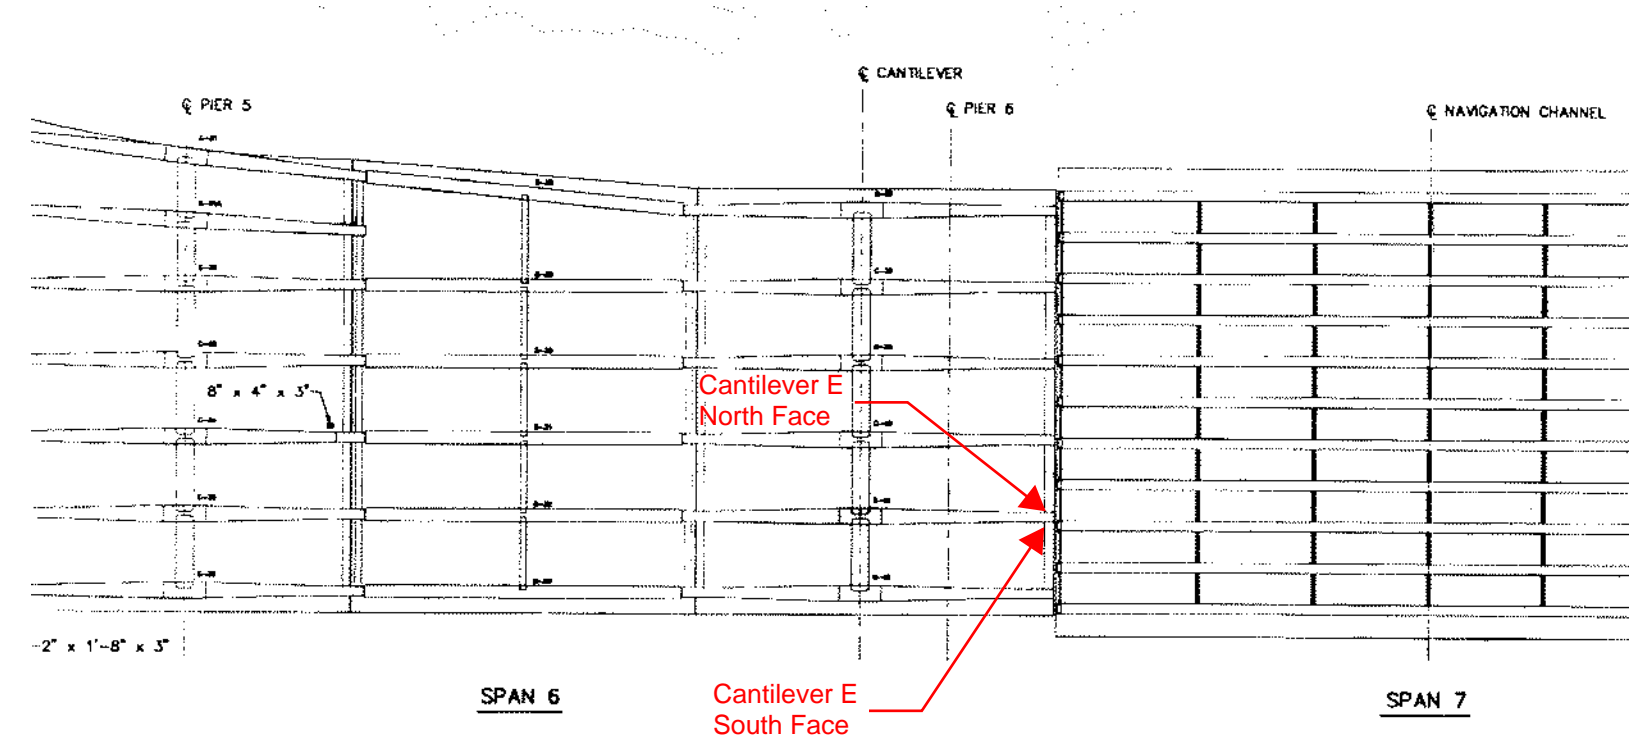

Cantilever E North Face

Cantilever E South Face

Note:  
 - Spalls on diaphragm at Cantilever E north and south face. Tie down steel rod exposed with heavy rusting.

Photo #1

Bouncing of steel rod  
observed under live load

1" diameter  
remaining at base

Cantilever A North Face at Pier 6  
(Looking South)

Bridge # 070001

12/08/ 2023

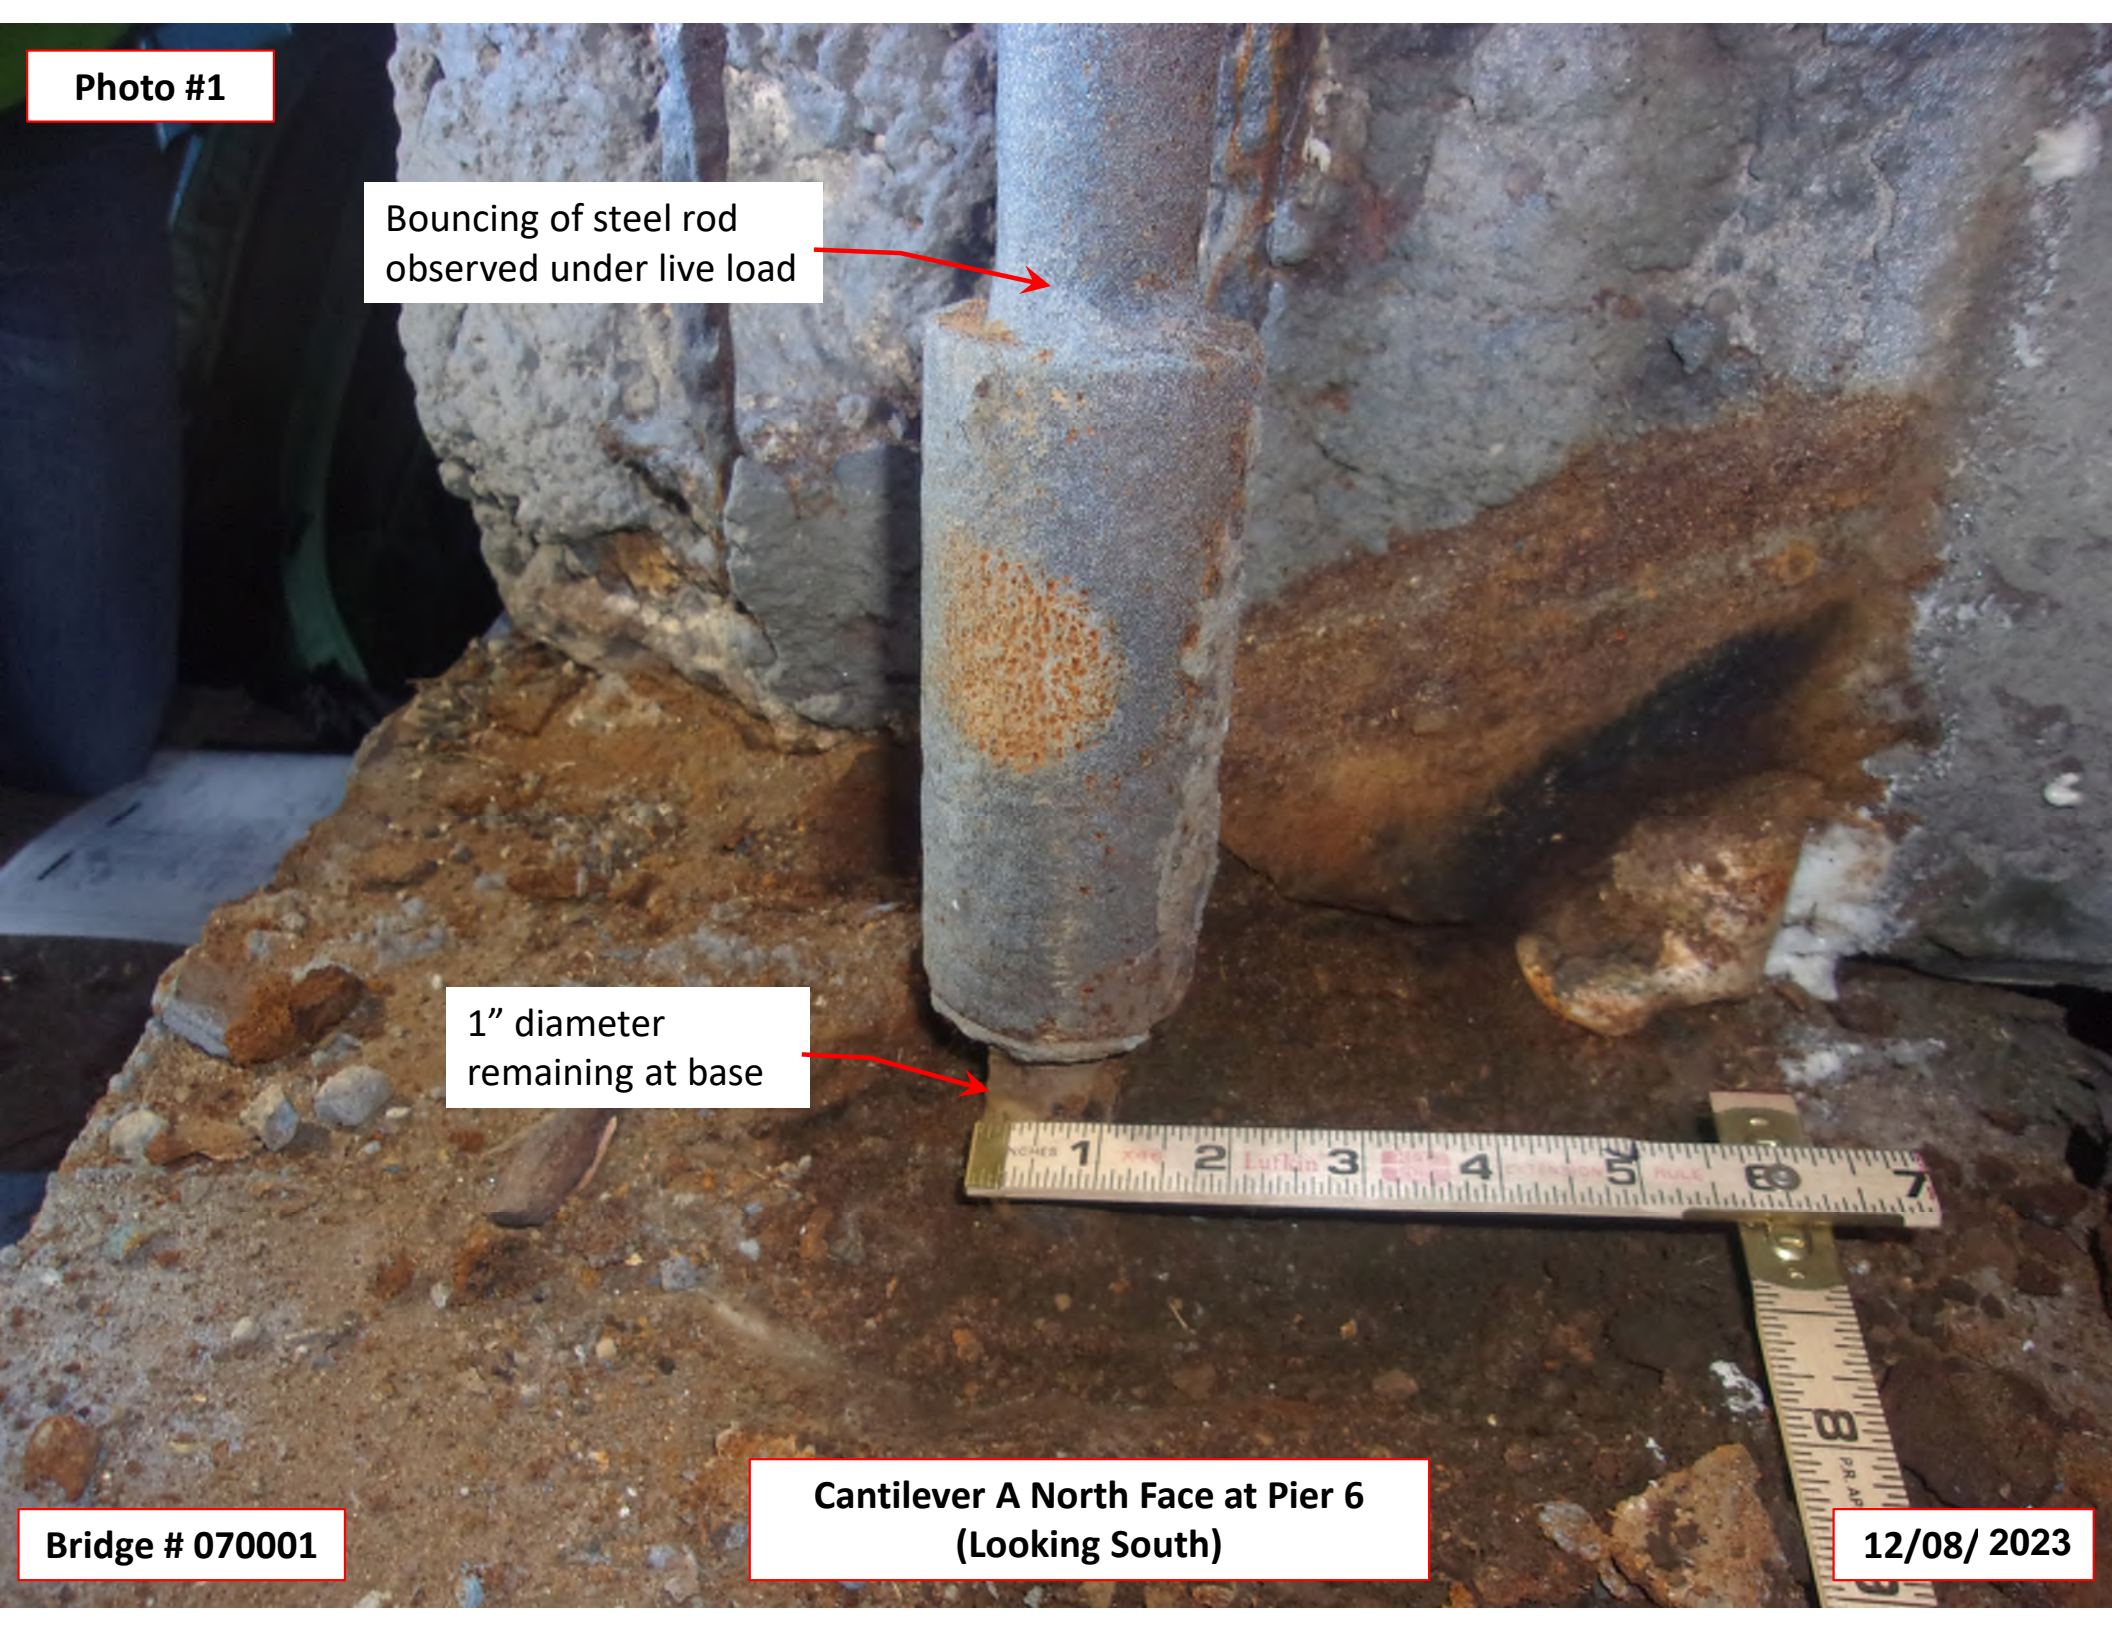


Photo #2



Bouncing of cantilever end observed under live load

Gap between cantilever and beam seat

Bridge # 070001

Cantilever A East Face at Pier 6  
(Looking West)

12/08/ 2023

Photo #3



Steel rod sheared at top

Failed tiedown

Cantilever A North Face at Pier 7  
(Looking South)

Bridge # 070001

12/08/ 2023

**Photo #4**

Steel rod sheared at top



**Bridge # 070001**

**Cantilever A North Face at Pier 7  
(Looking South)**

**12/08/ 2023**

Photo #5

Steel rod sheared at top


Bridge # 070001

Cantilever A North Face at Pier 7  
(Looking South)

12/08/ 2023

Photo #6

1" diameter remaining  
near base



Cantilever F South Face at Pier 6  
(Looking North)

Bridge # 070001

12/08/ 2023

**Photo #7**



1" diameter remaining  
near base

**Cantilever F South Face at Pier 6  
(Looking North)**

**Bridge # 070001**

**12/08/ 2023**

Photo #8

Steel rod sheared  
near base


Cantilever F South Face at Pier 7  
(Looking North)

Bridge # 070001

12/08/ 2023

Photo #9

Gap between  
cantilever end and  
seat




Bridge # 070001

Cantilever F West Face at Pier 7  
(Looking East)




12/08/ 2023

# 1967 Record Plans

| FED. ROAD DIV. NO. | STATE | FED. AID PROJ. NO. | FISCAL YEAR | SHEET NO. | TOTAL SHEETS |
|--------------------|-------|--------------------|-------------|-----------|--------------|
| 1                  | R. I. | 1-195-41038        | 1968        | 71        | 223          |

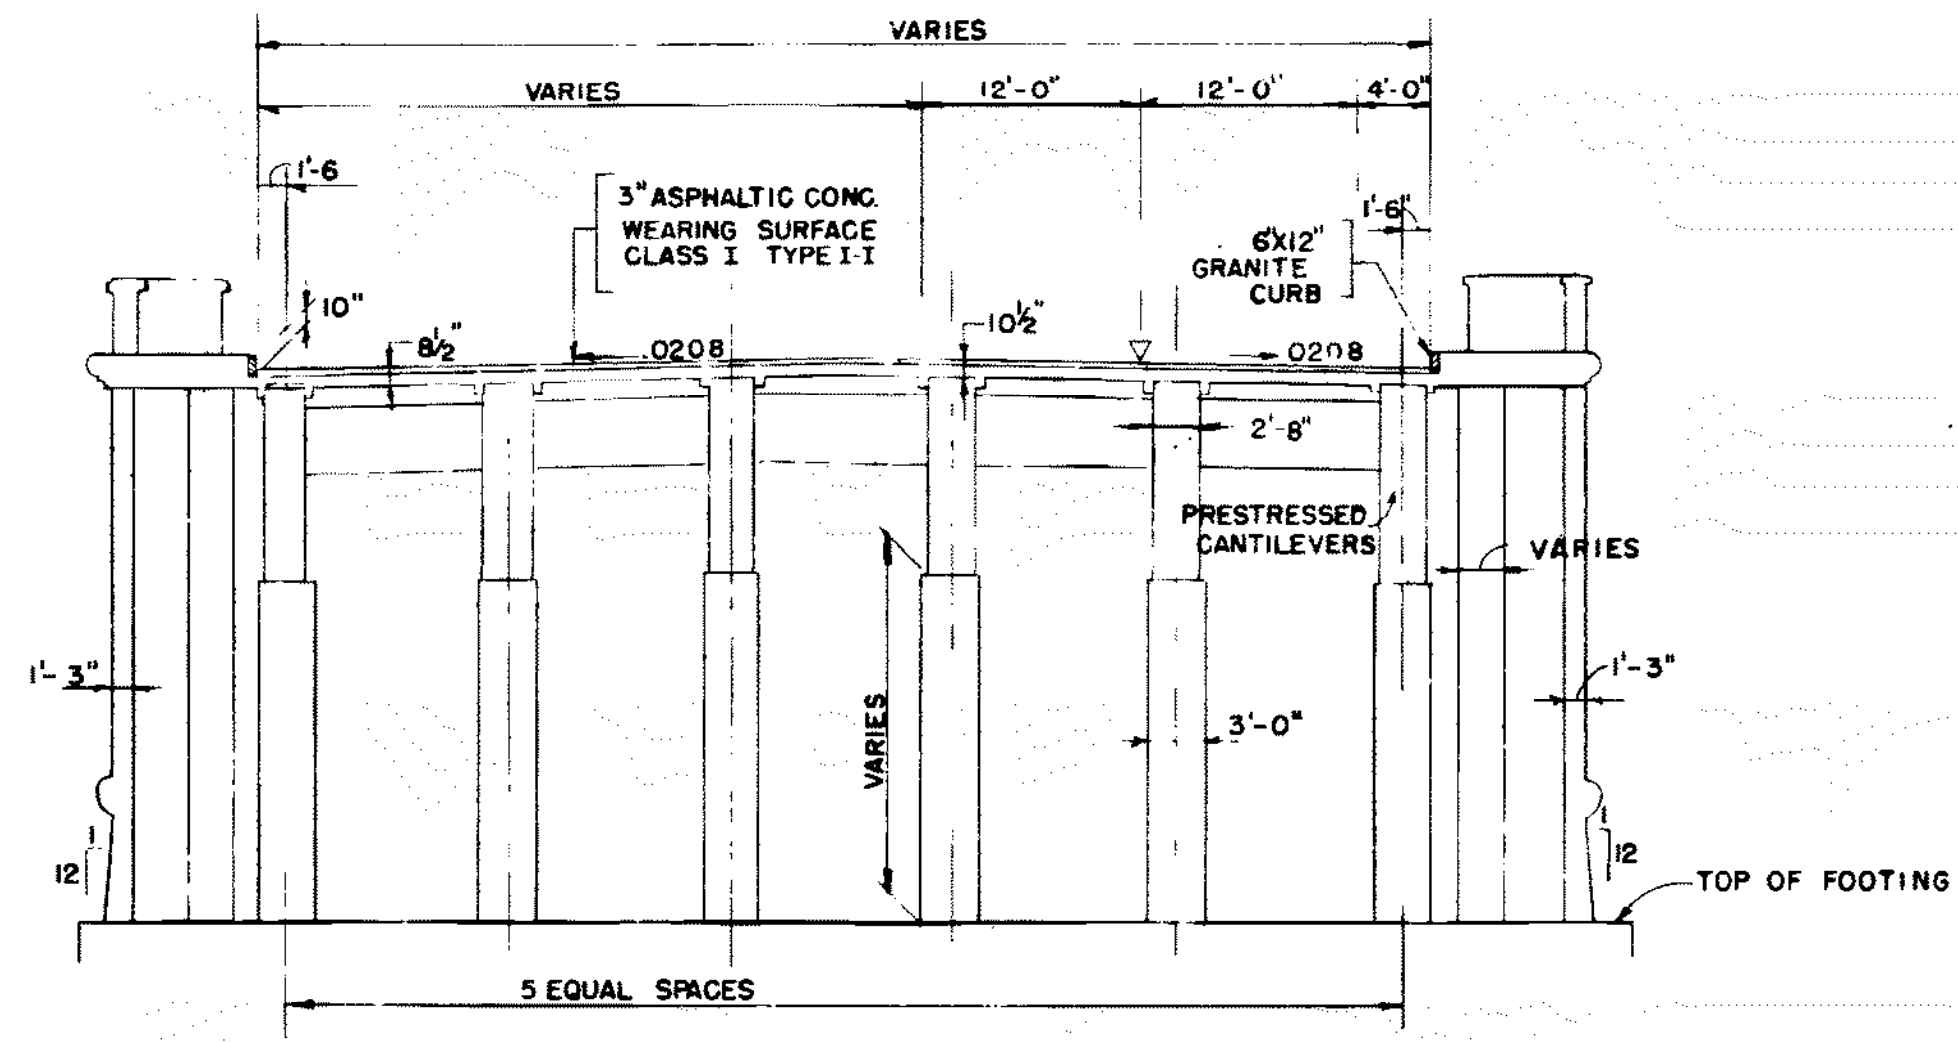


SECTION A-A  
SCALE: 1" = 10'

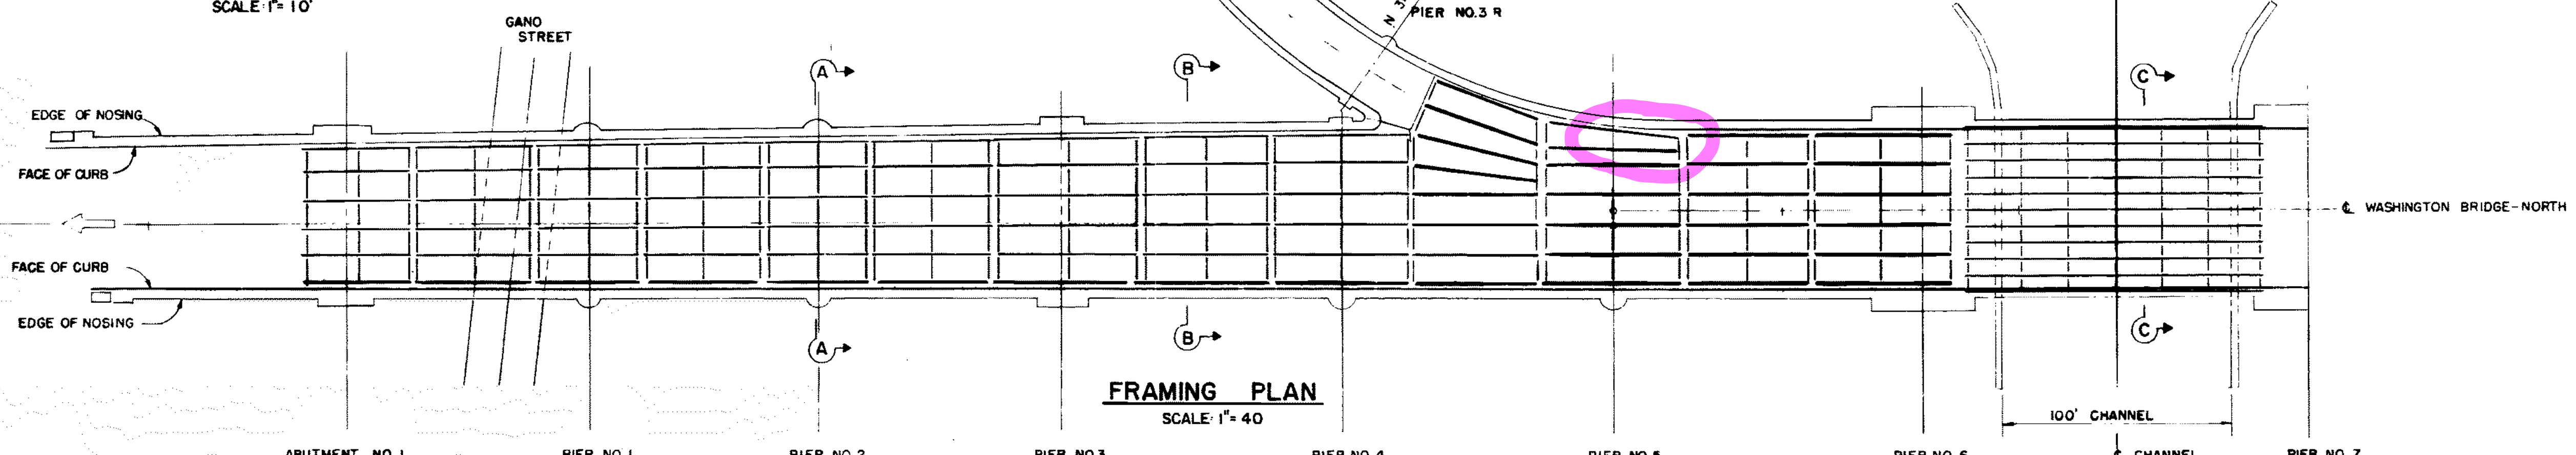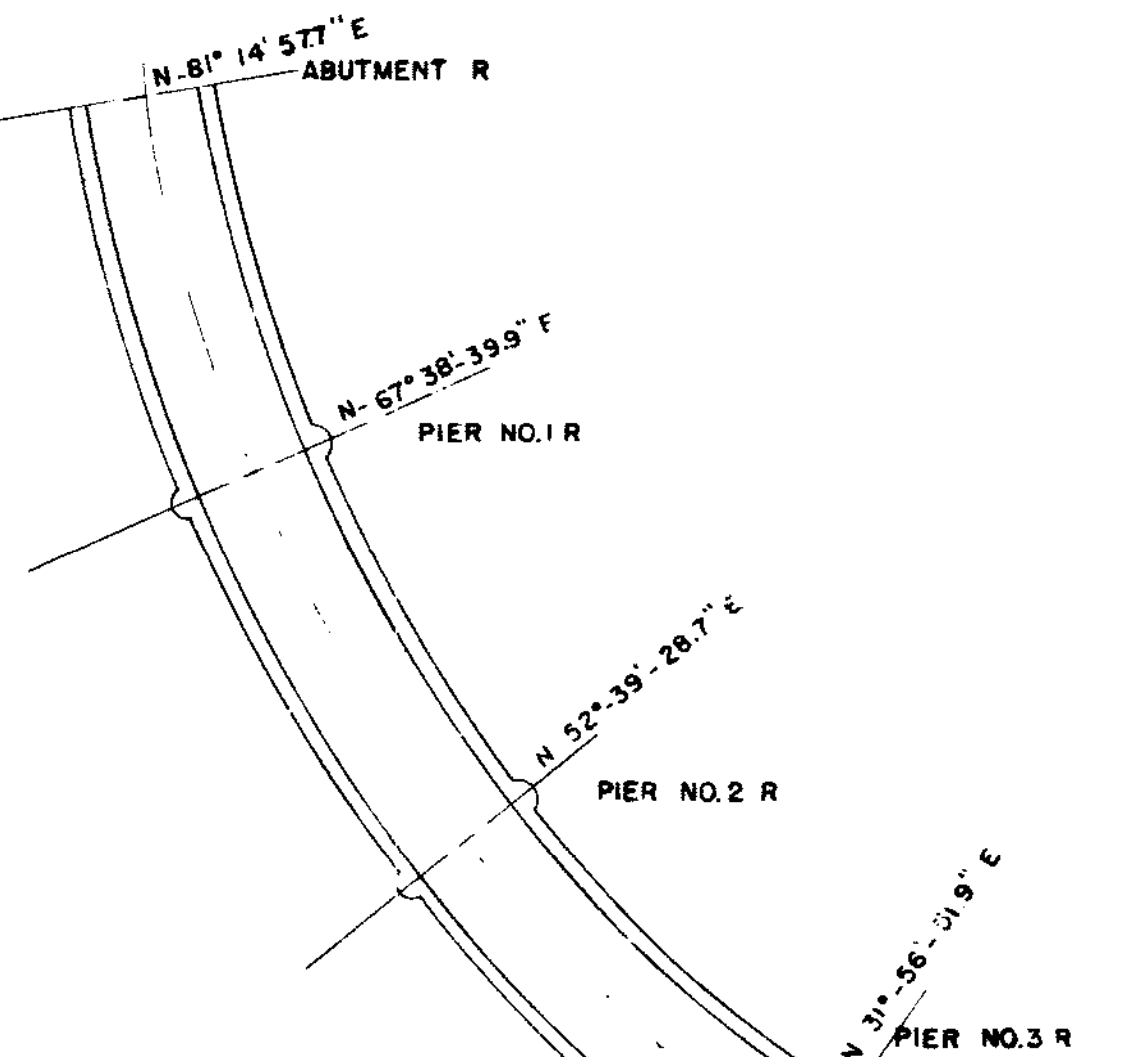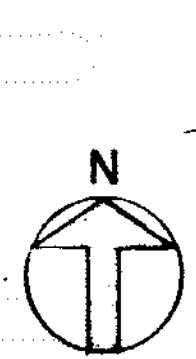


FRAMING PLAN  
SCALE: 1" = 40'

SEQUENCE OF DECK POURS


- Numbers within circles ① etc., indicate typical sequence of deck pours.
- All ① pours must be completed before figure ② pours, etc.
- The sequence indicated is based on order of pours proceeding from Abutment No. 1 toward Pier 6 and from Pier 13 toward Pier 7. Similar sequence will apply as order of pours proceeds from Pier 6 toward Abutment 1 and Pier 7 toward Pier 13. Pours may commence from either end or both ends simultaneously.
- The Contractor shall submit his actual proposed sequence of pours to the Engineer for review 30 days prior to making the initial pour. The sequencing shall be satisfactory to the Engineer and must be approved in writing.

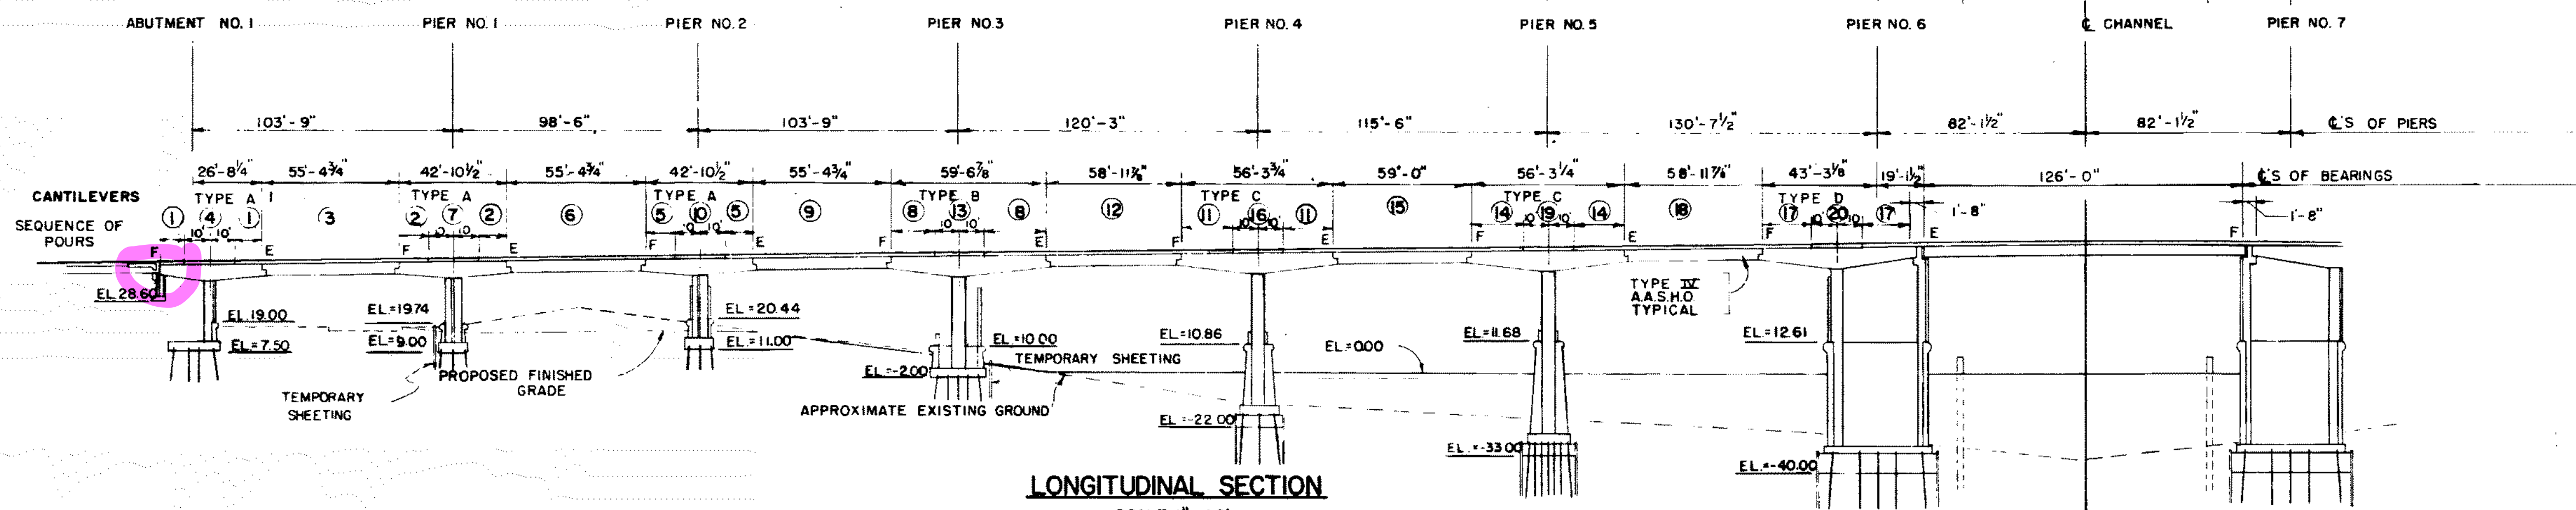

LONGITUDINAL SECTION  
SCALE: 1" = 40'

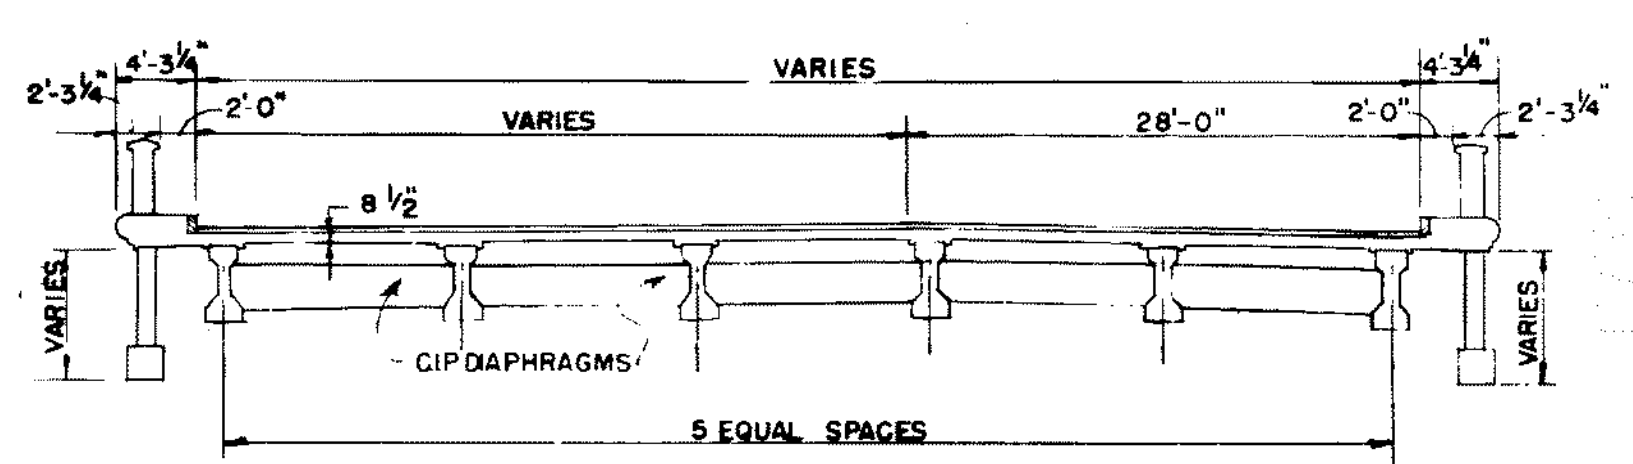

SECTION B-B  
SCALE: 1" = 10'

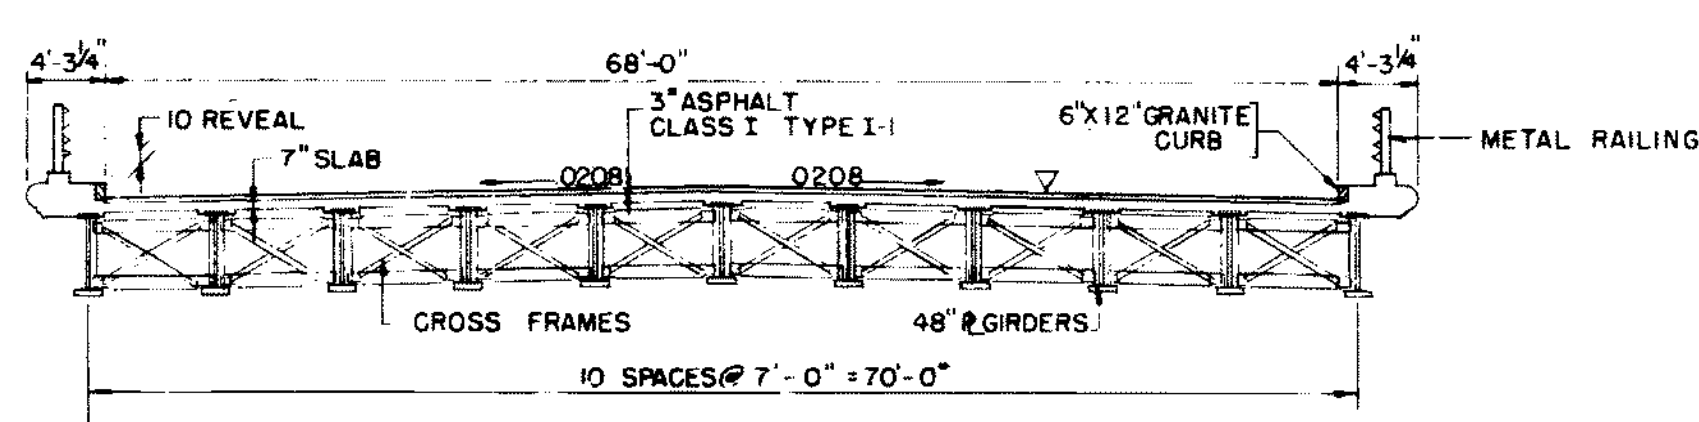






SECTION C-C  
SCALE: 1" = 10'

| REVISIONS |      |    |
|-----------|------|----|
| NO.       | DATE | BY |
|           |      |    |
|           |      |    |
RHODE ISLAND  
DEPARTMENT OF PUBLIC WORKS  
DIVISION OF ROADS AND BRIDGES  
**WASHINGTON BRIDGE (NORTH)**  
CROSSING SEEKONK RIVER  
PROVIDENCE-EAST PROVIDENCE, RHODE ISLAND  
**FRAMING PLAN & SECTIONS- I**  
STA. 21+85 TO 29+46

**CHARLES A. MAGUIRE & ASSOCIATES**  
ENGINEERS  
PROVIDENCE, R. I. BOSTON, MASS.  
DATE JAN 1967 DESIGNED BY  
SCALE AS SHOWN SHEET 71 OF 223

APPROVED \_\_\_\_\_ SET NO. \_\_\_\_\_  
SUPERVISING CIVIL ENGINEER (BRIDGE) PRINTED  
APPROVED \_\_\_\_\_  
CHIEF ENGINEER ISSUED TO \_\_\_\_\_  
FINAL DATE \_\_\_\_\_

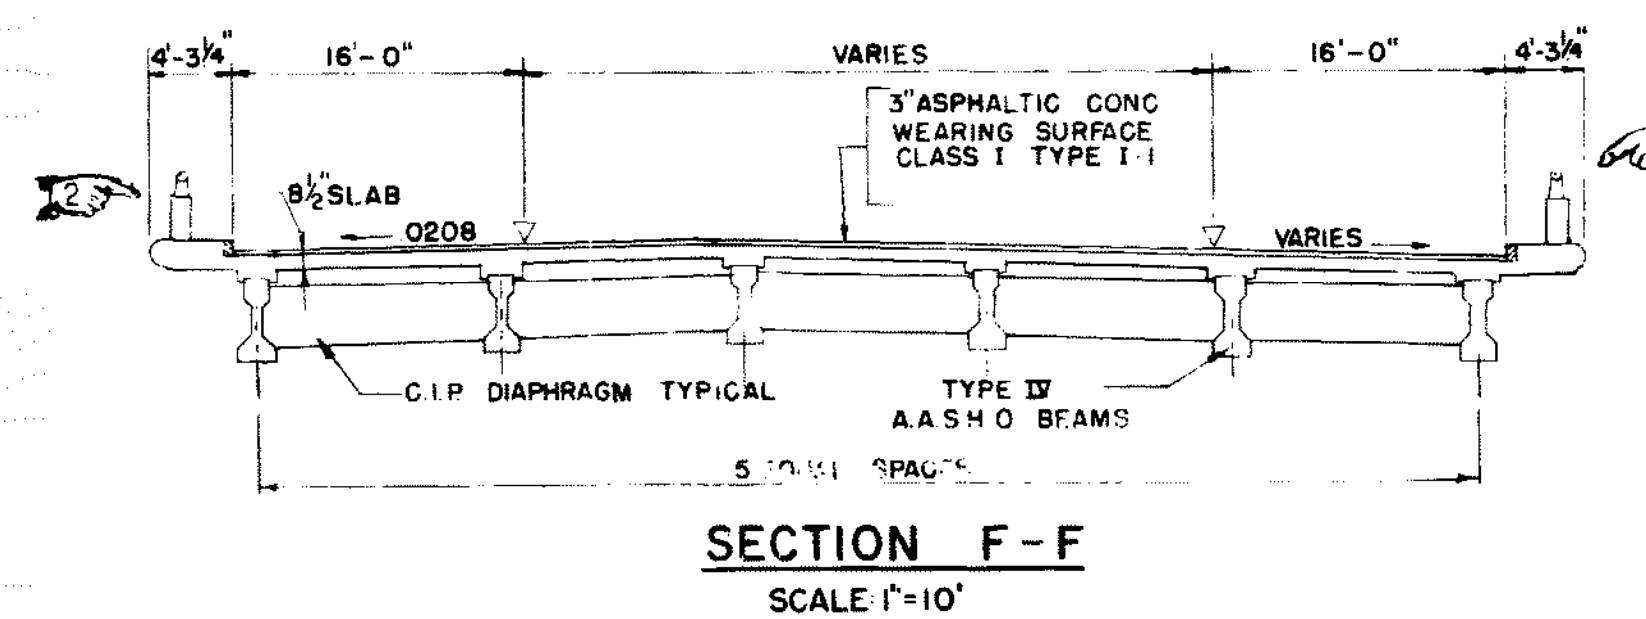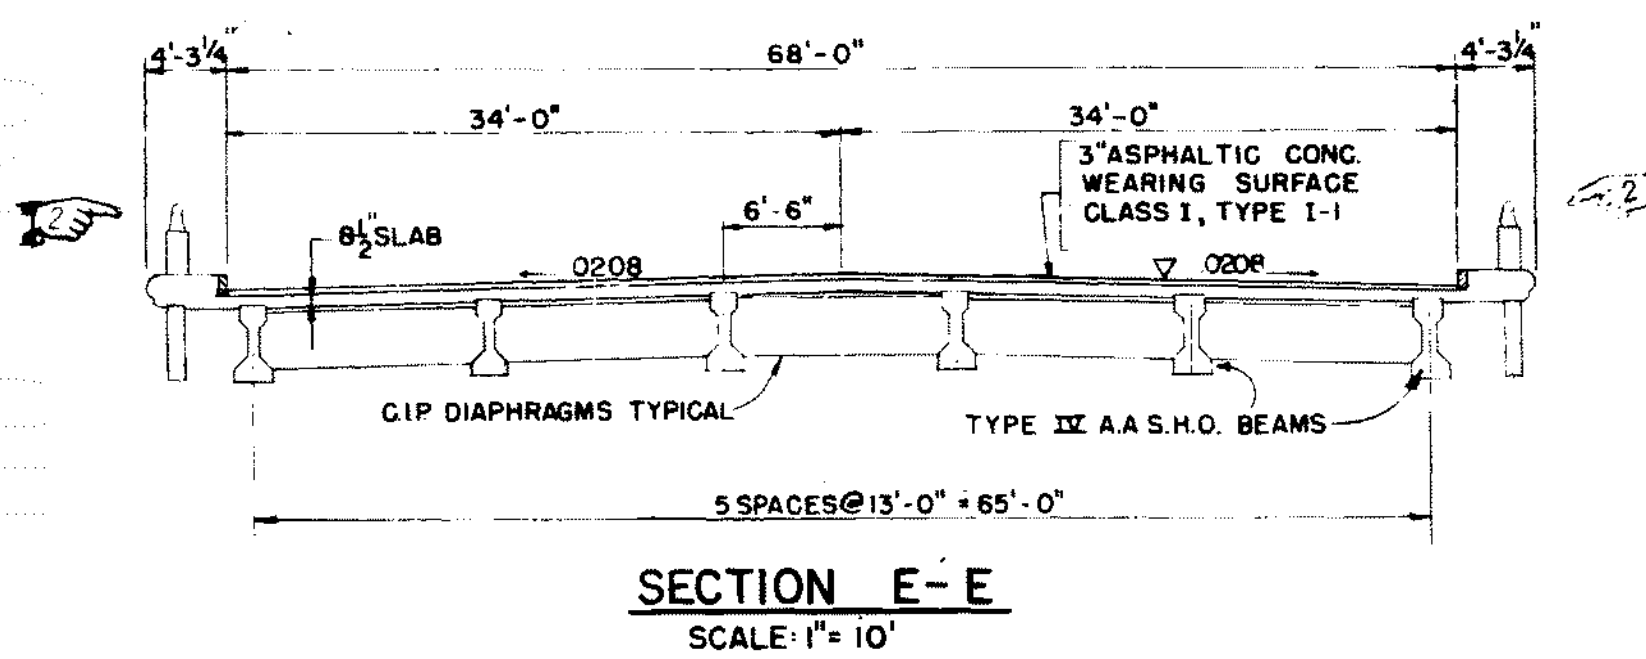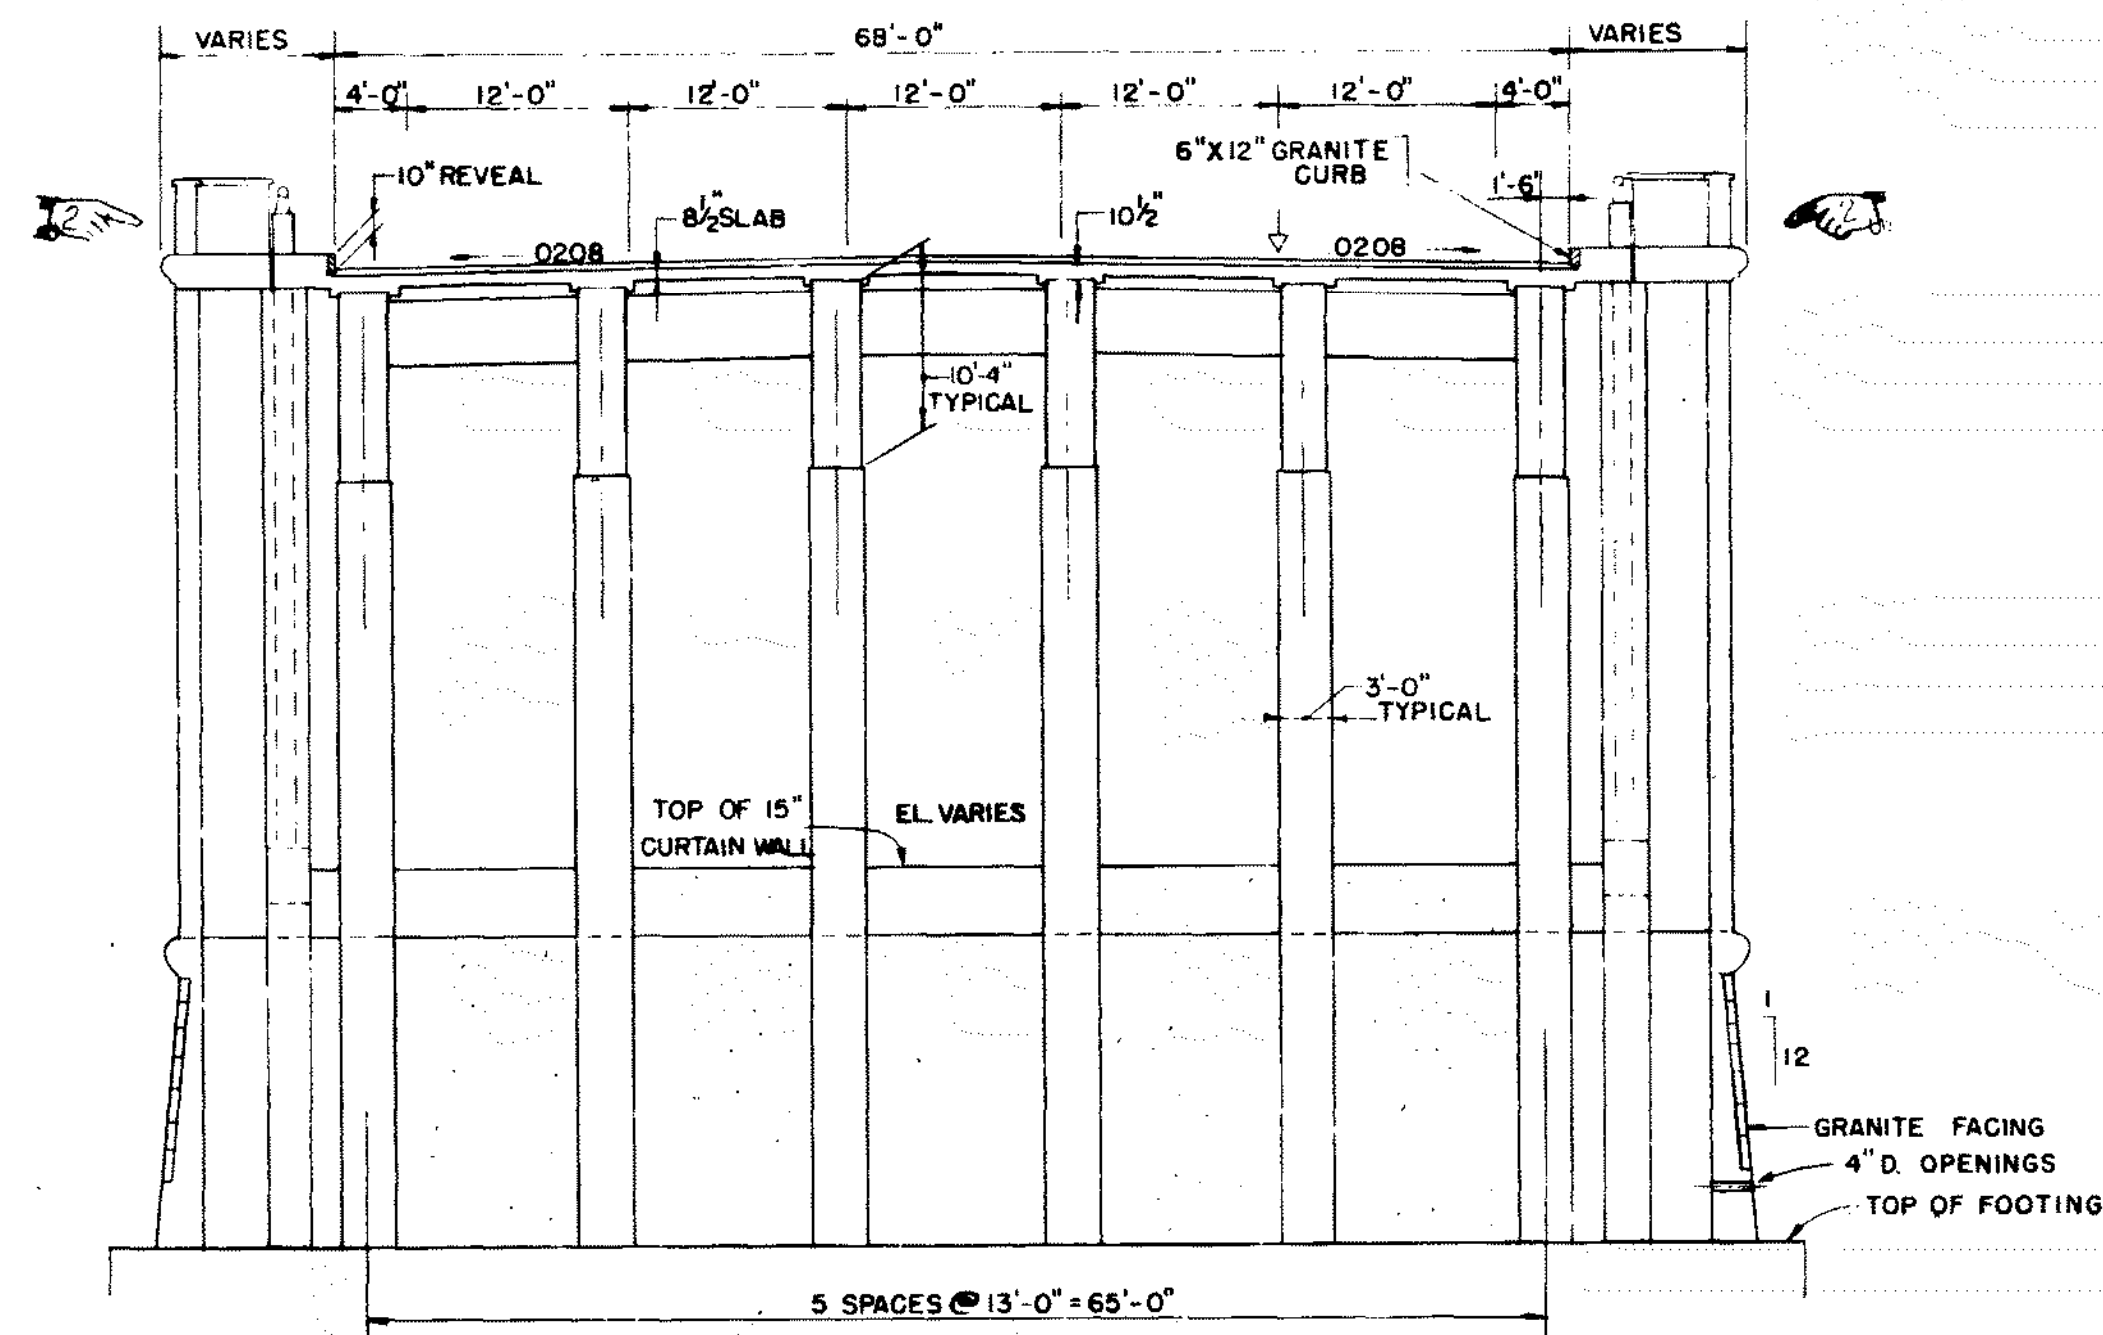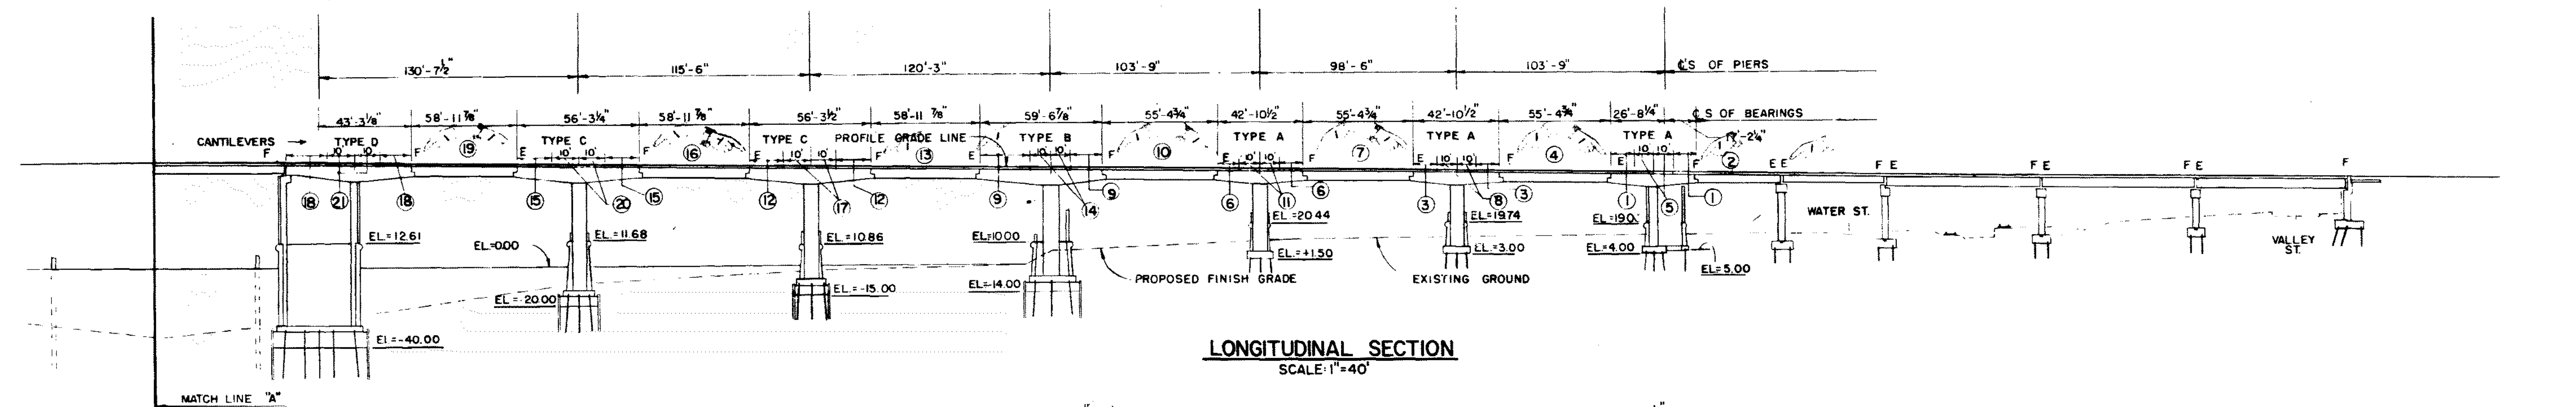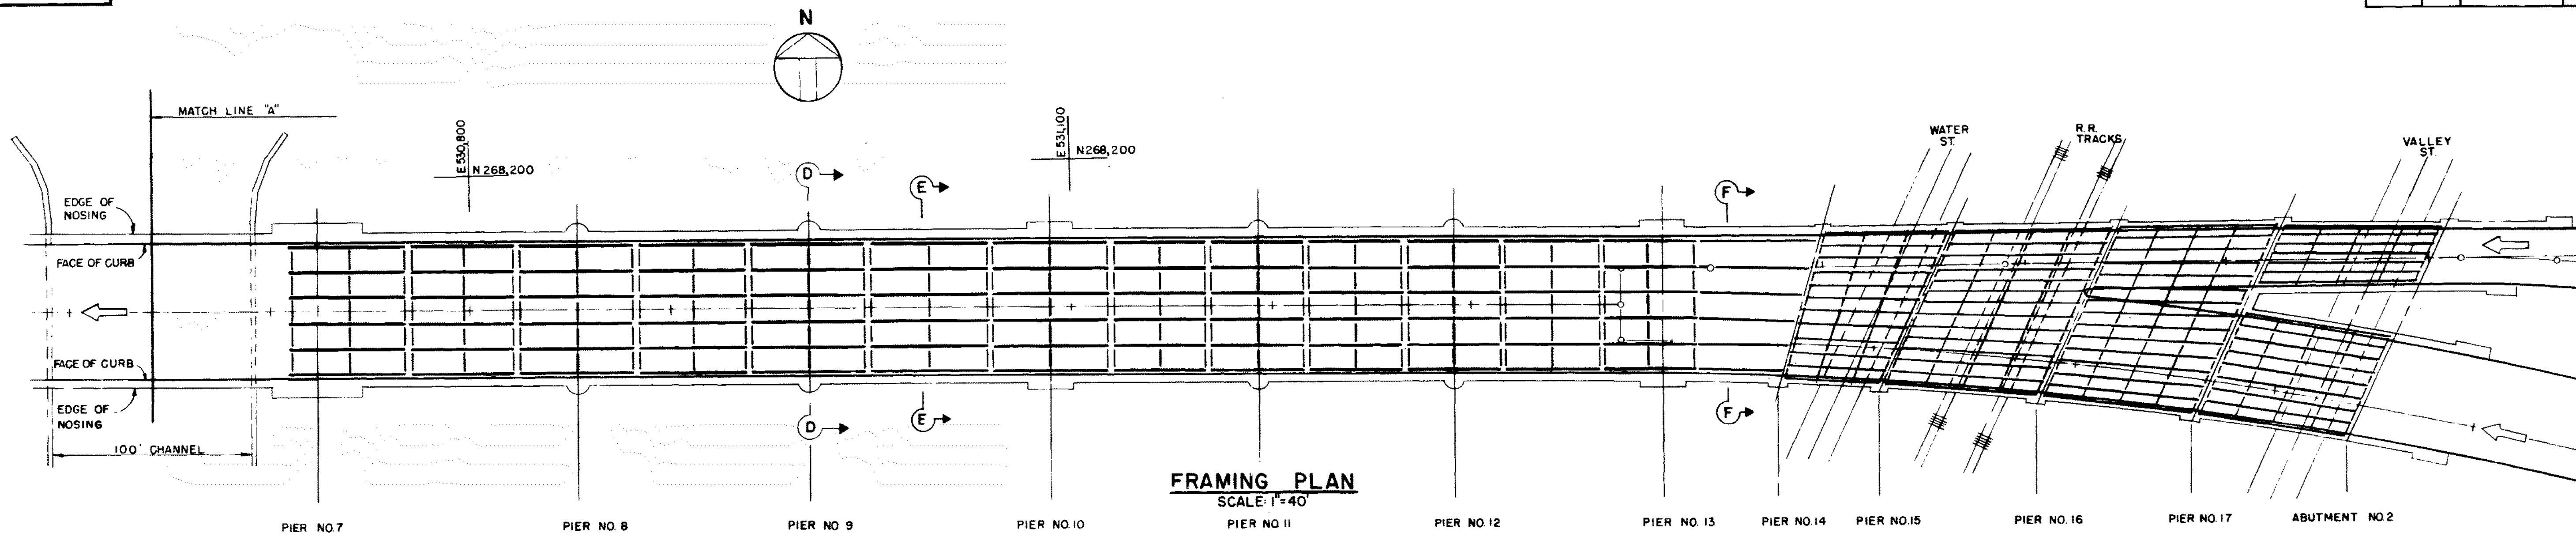

| REVISIONS |         |        |
|-----------|---------|--------|
| NO.       | DATE    | BY     |
| 1         | 7-15-68 | J.M.C. |
| 2         | 8-8-68  | RC     |

RHODE ISLAND  
DEPARTMENT OF PUBLIC WORKS  
DIVISION OF ROADS AND BRIDGES

**WASHINGTON BRIDGE (NORTH)**

CROSSING SEEKONK RIVER  
PROVIDENCE-EAST PROVIDENCE, RHODE ISLAND

**FRAMING PLAN & SECTIONS-2**  
STA. 29+46 TO 42+50










**CHARLES A. MAGUIRE & ASSOCIATES**  
ENGINEERS  
PROVIDENCE, R. I. BOSTON, MASS.

DATE JAN 1967 DESIGNED BY  
SCALE AS SHOWN SHEET 72 OF 223


APPROVED \_\_\_\_\_ SET NO. \_\_\_\_\_  
SUPERVISING CIVIL ENGINEER (BRIDGE) PRINTED

APPROVED \_\_\_\_\_  
CHIEF ENGINEER ISSUED TO \_\_\_\_\_

FINAL DATE \_\_\_\_\_

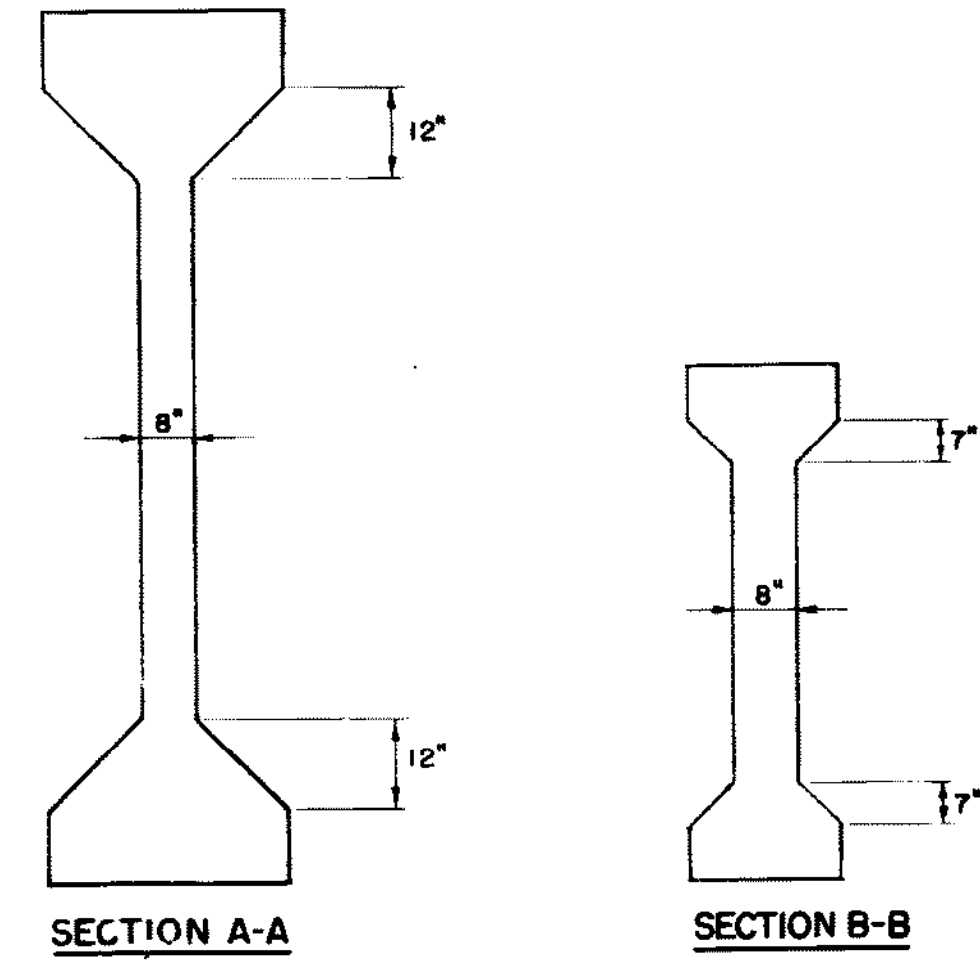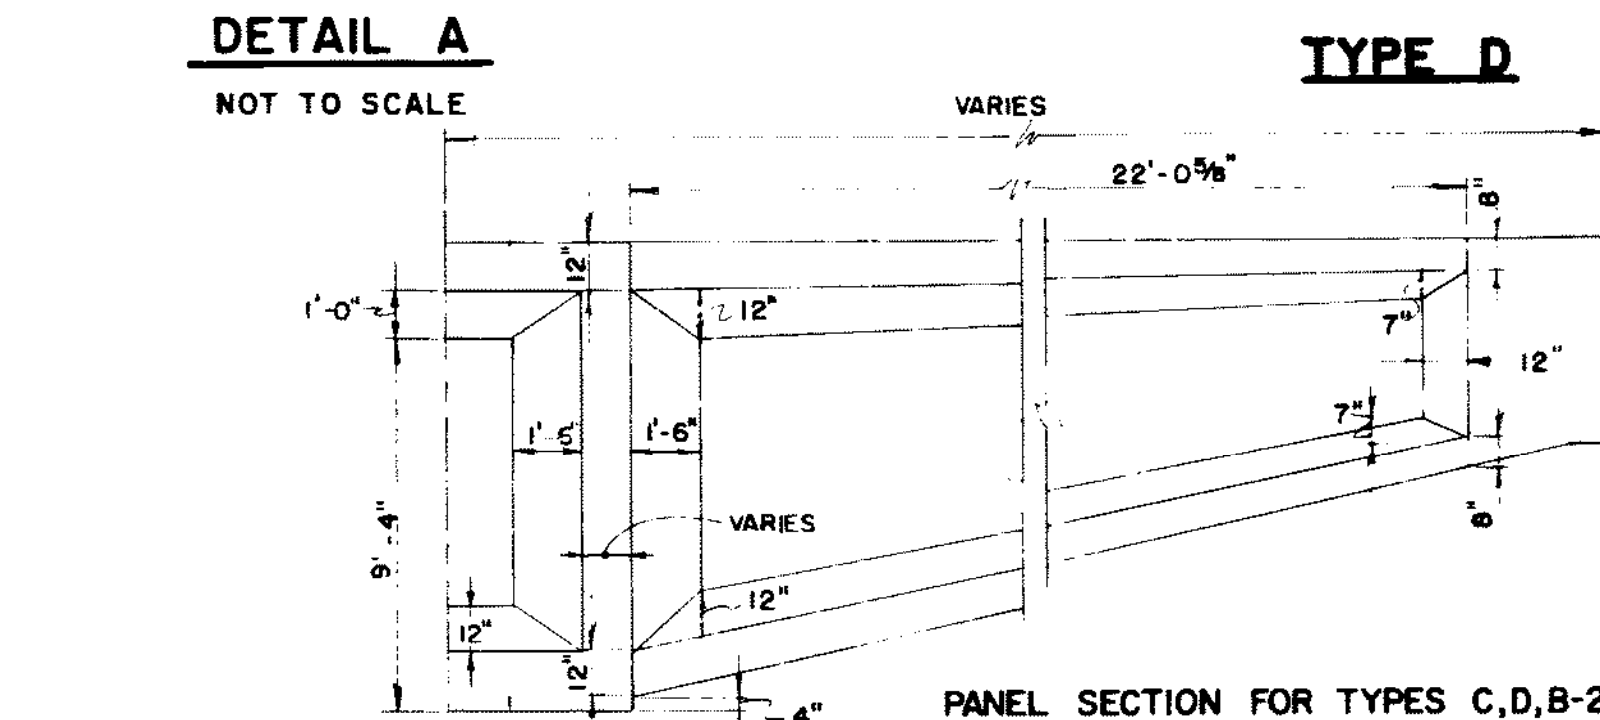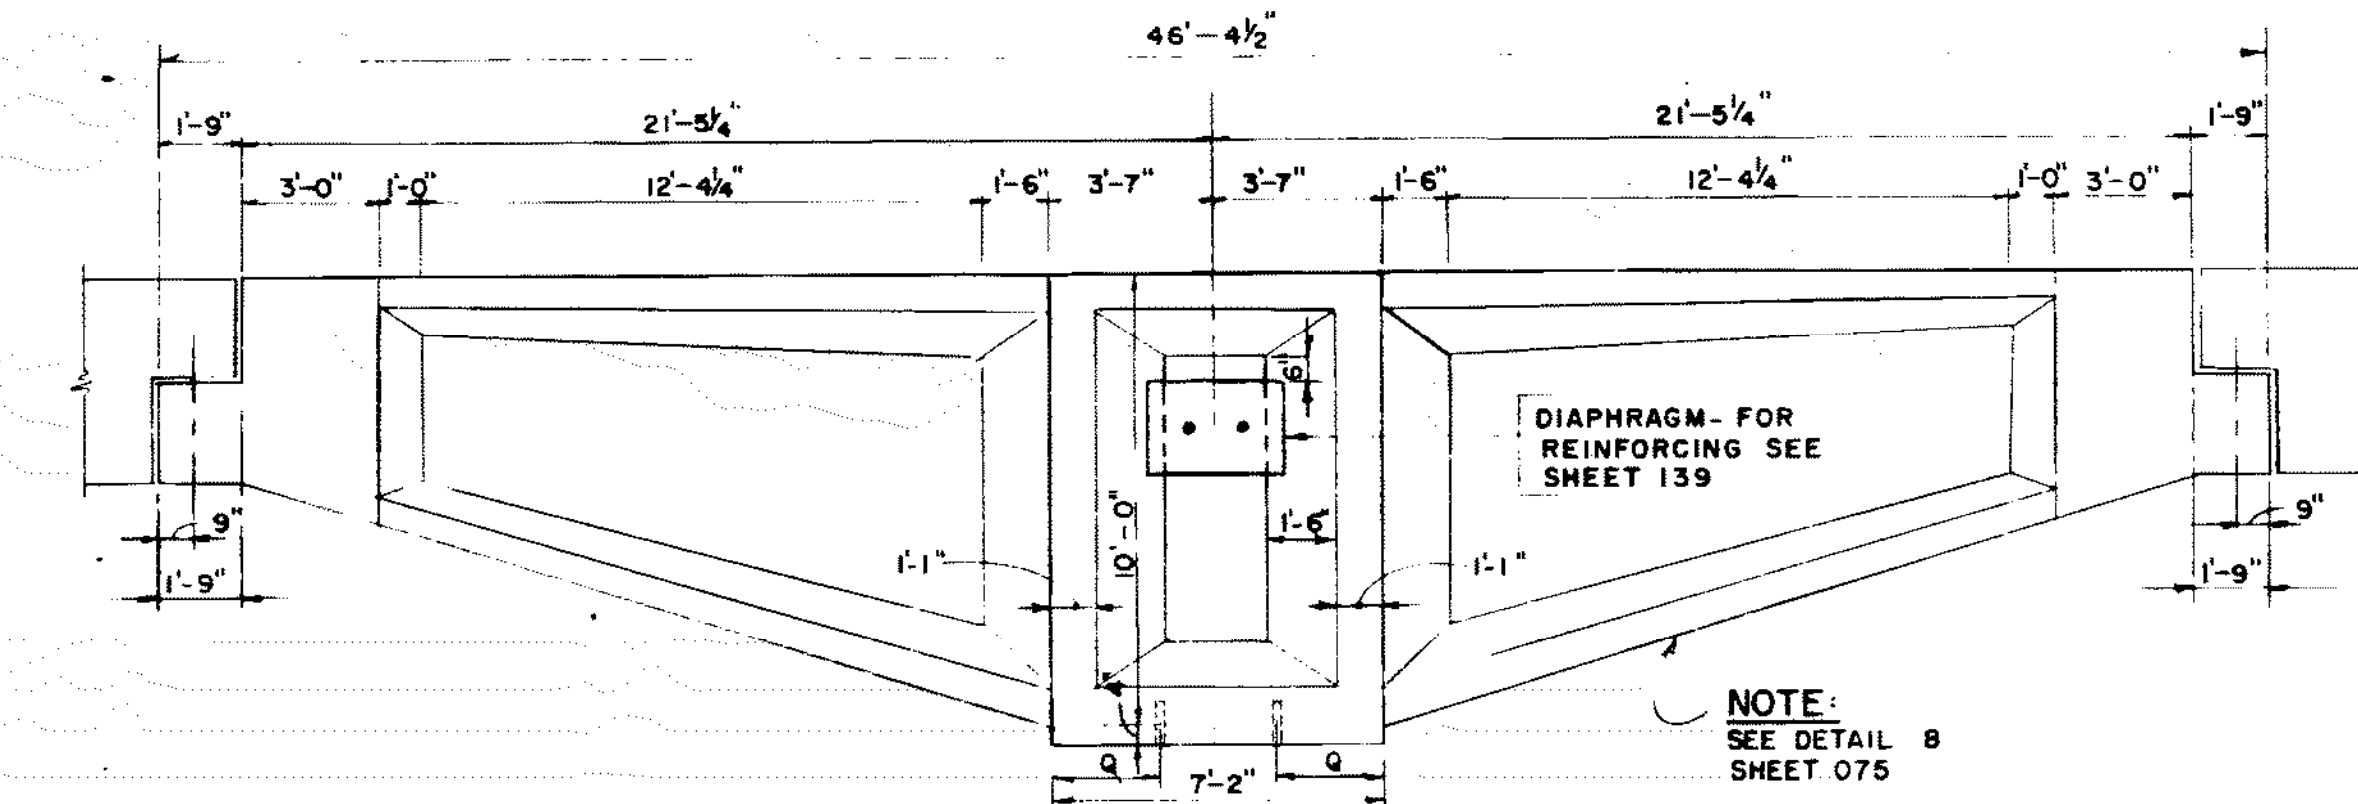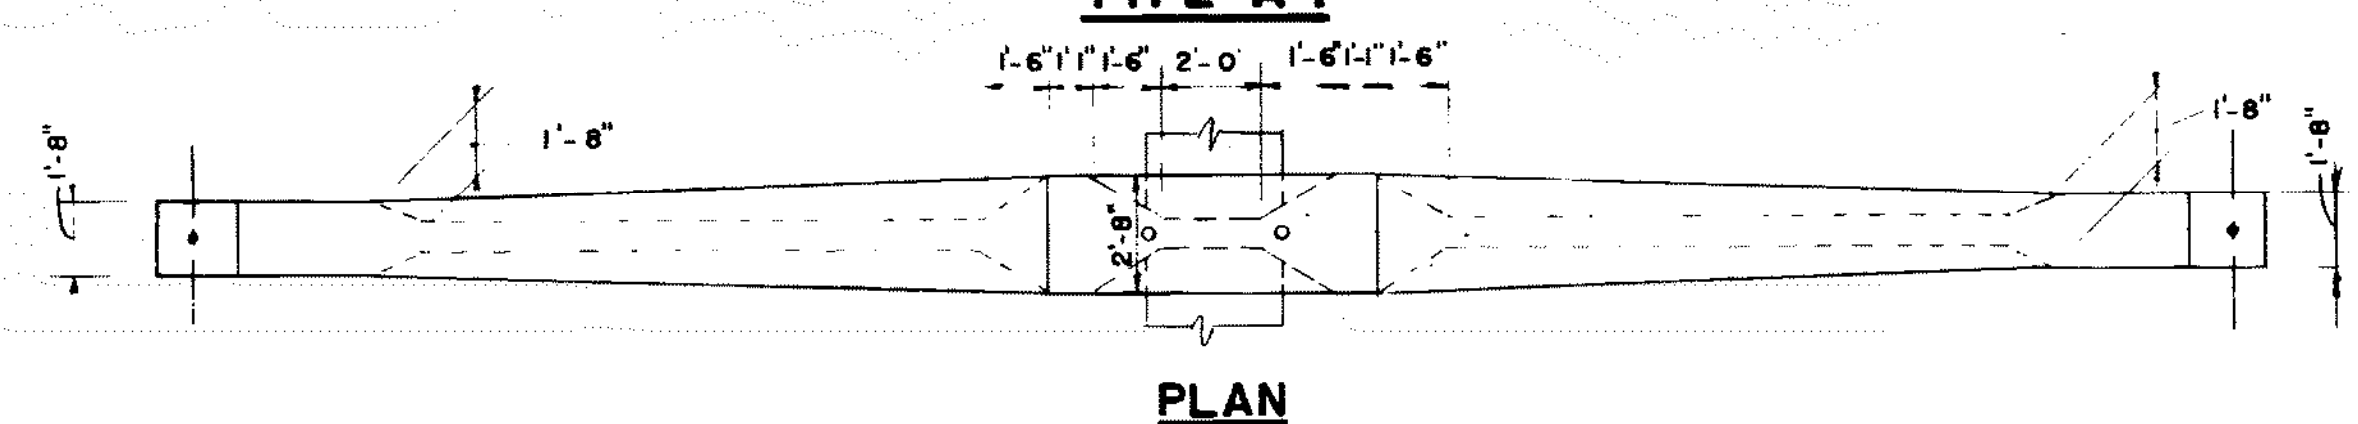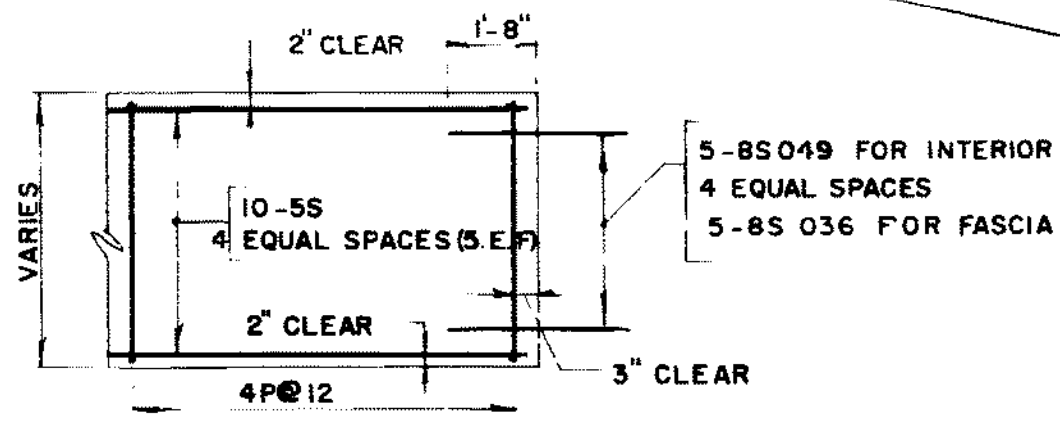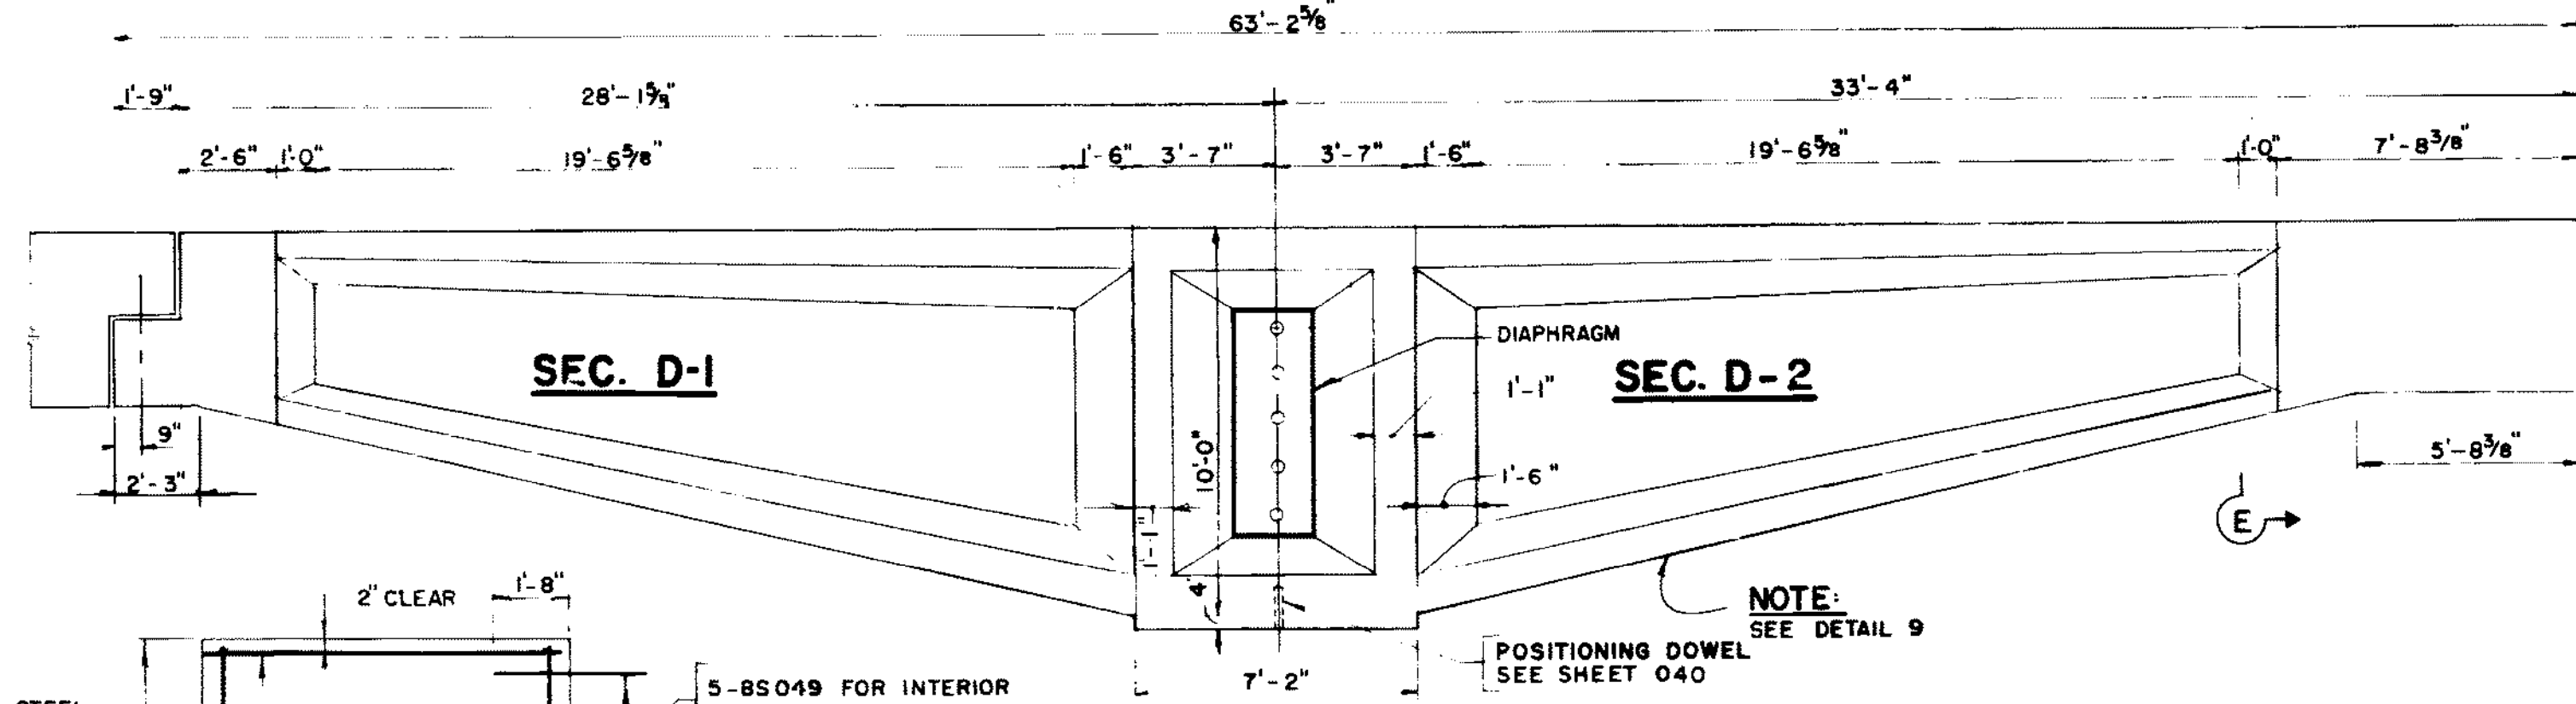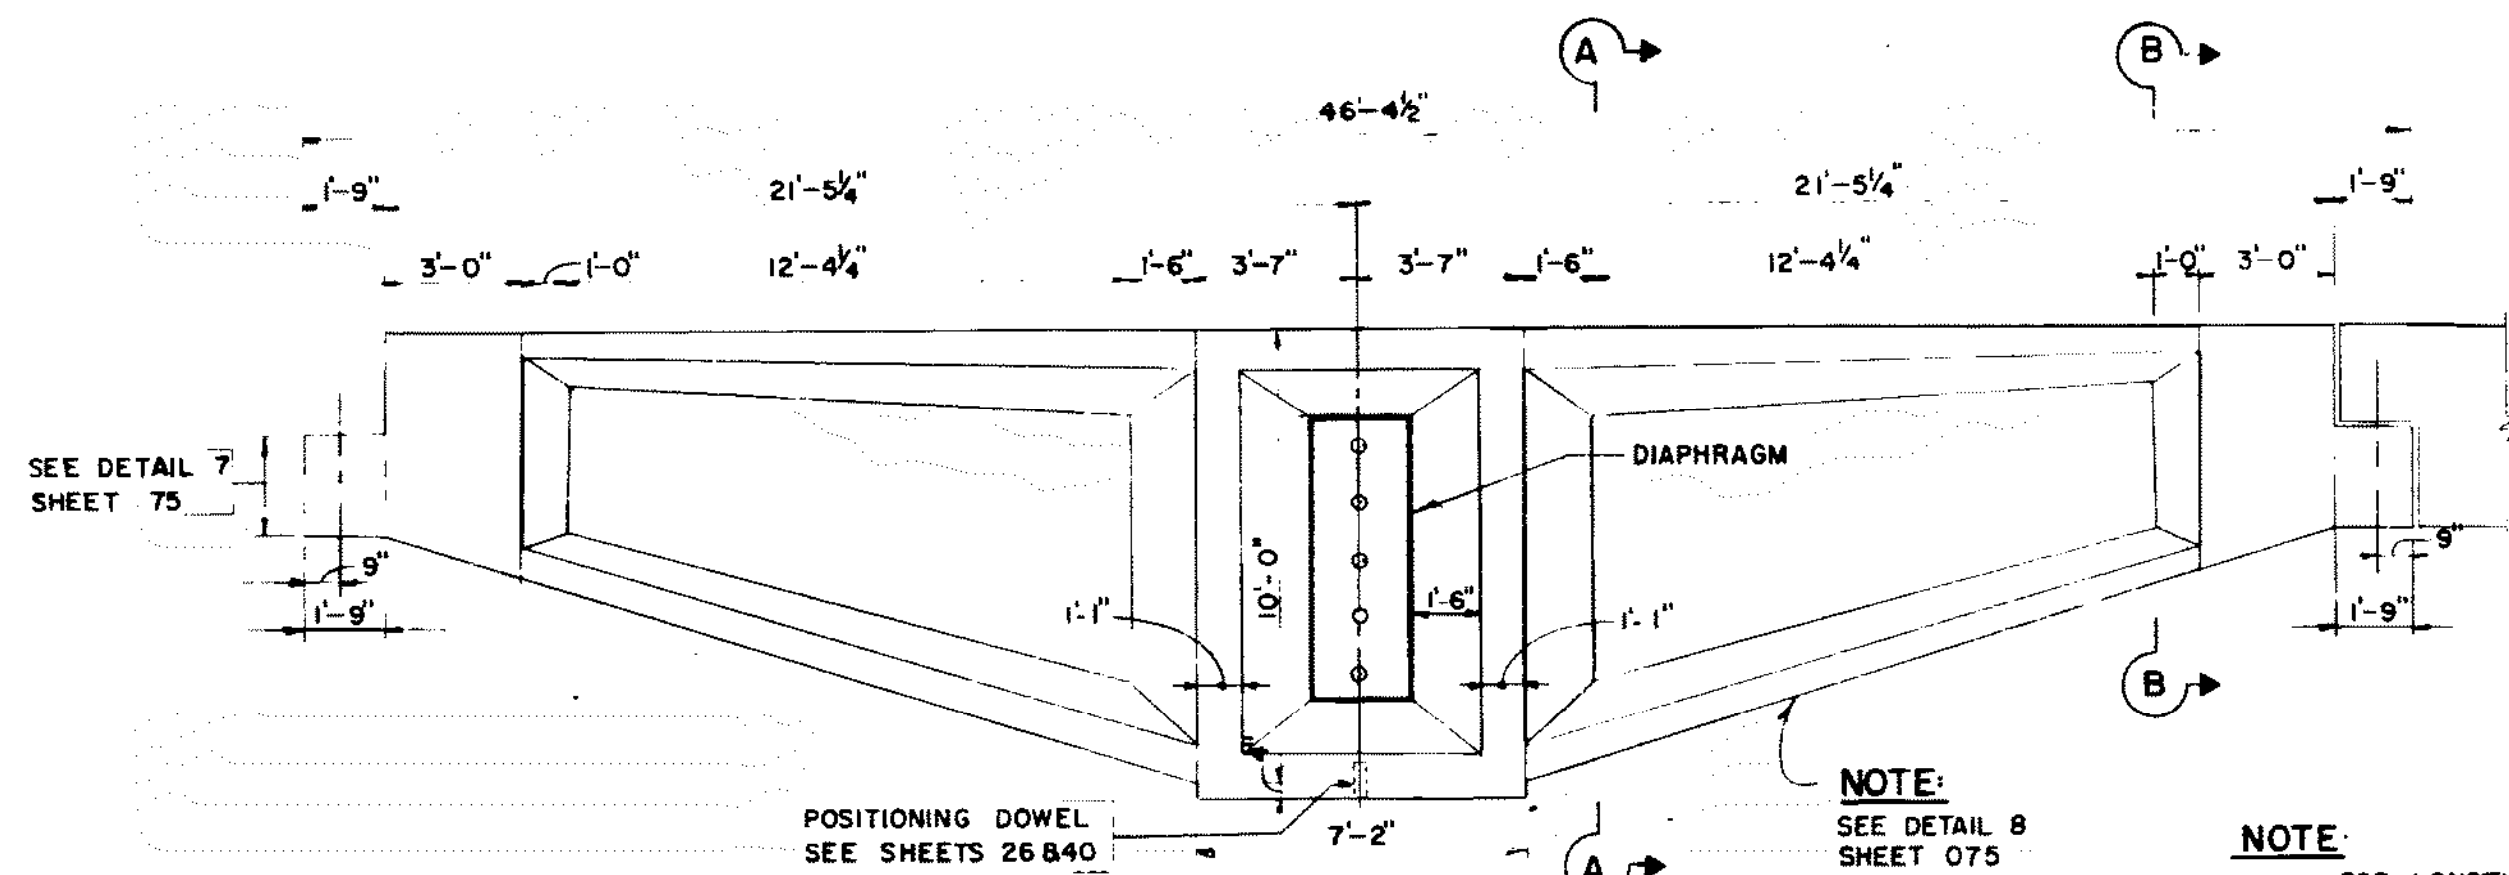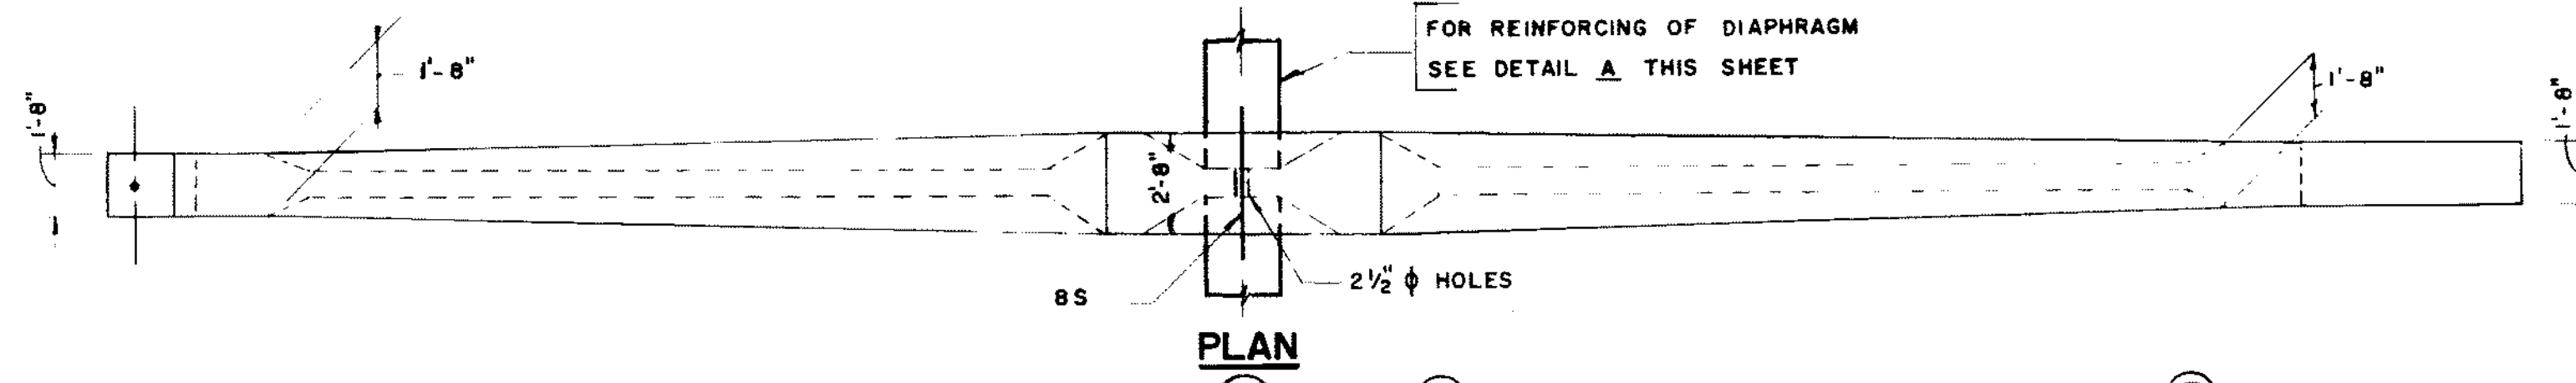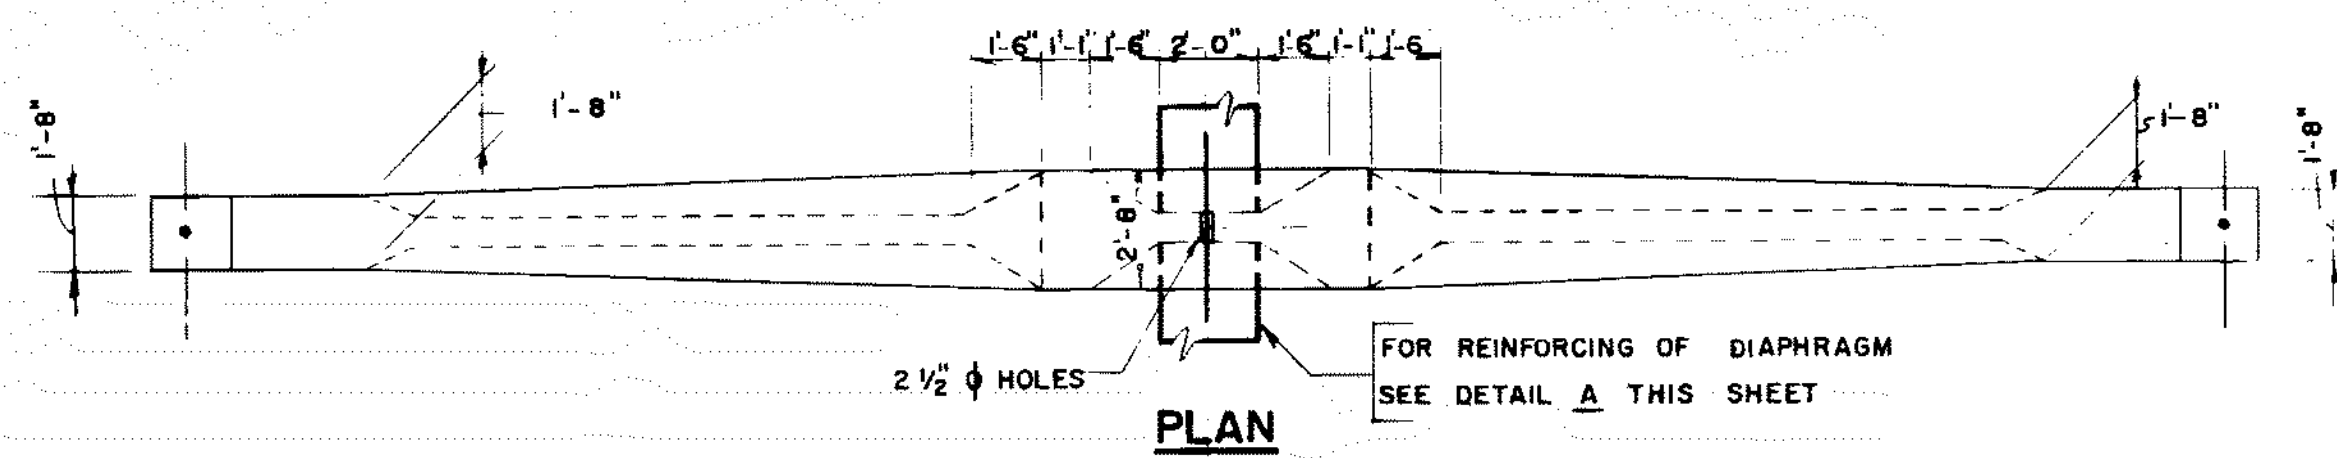

SCALE: 1/2" = 1'-0"

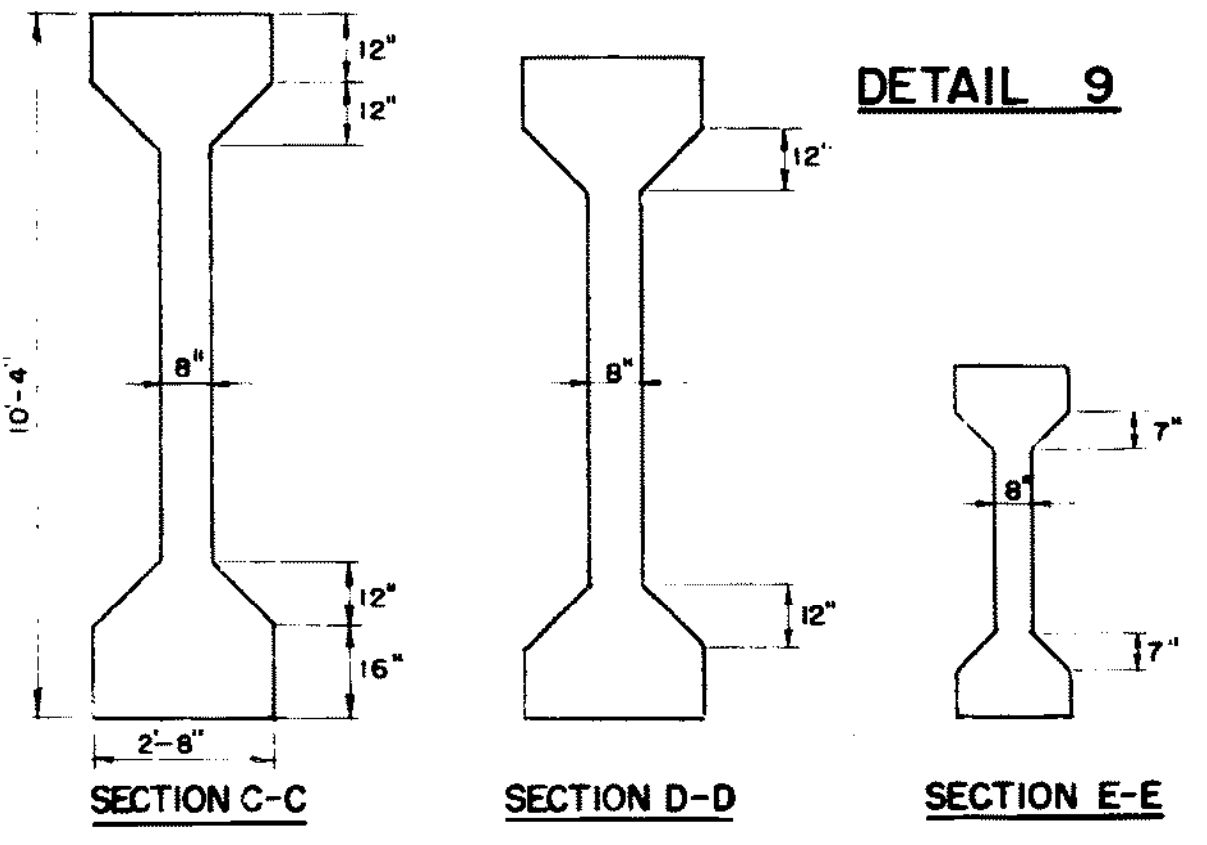

NOTE: SEE NOTES ON SHEET 078

| REVISIONS |      |    |
|-----------|------|----|
| NO.       | DATE | BY |
|           |      |    |
|           |      |    |
RHODE ISLAND  
DEPARTMENT OF PUBLIC WORKS  
DIVISION OF ROADS AND BRIDGES  
**WASHINGTON BRIDGE (NORTH)**  
CROSSING SEEKONK RIVER  
PROVIDENCE - EAST PROVIDENCE, RHODE ISLAND

**CANTILEVERS SHEET - 1**

CHARLES A. MAGUIRE & ASSOCIATES  
ENGINEERS  
PROVIDENCE, R. I.  
DATE: JAN 1967  
SCALE: 1/4" = 1'-0"  
EXCEPT AS NOTED









APPROVED: \_\_\_\_\_  
SUPERVISING CIVIL ENGINEER (BRIDGE)

APPROVED: \_\_\_\_\_  
CHIEF ENGINEER

FINAL DATE: \_\_\_\_\_

SET NO. \_\_\_\_\_  
PRINTED \_\_\_\_\_  
ISSUED TO \_\_\_\_\_

M. PETERSON

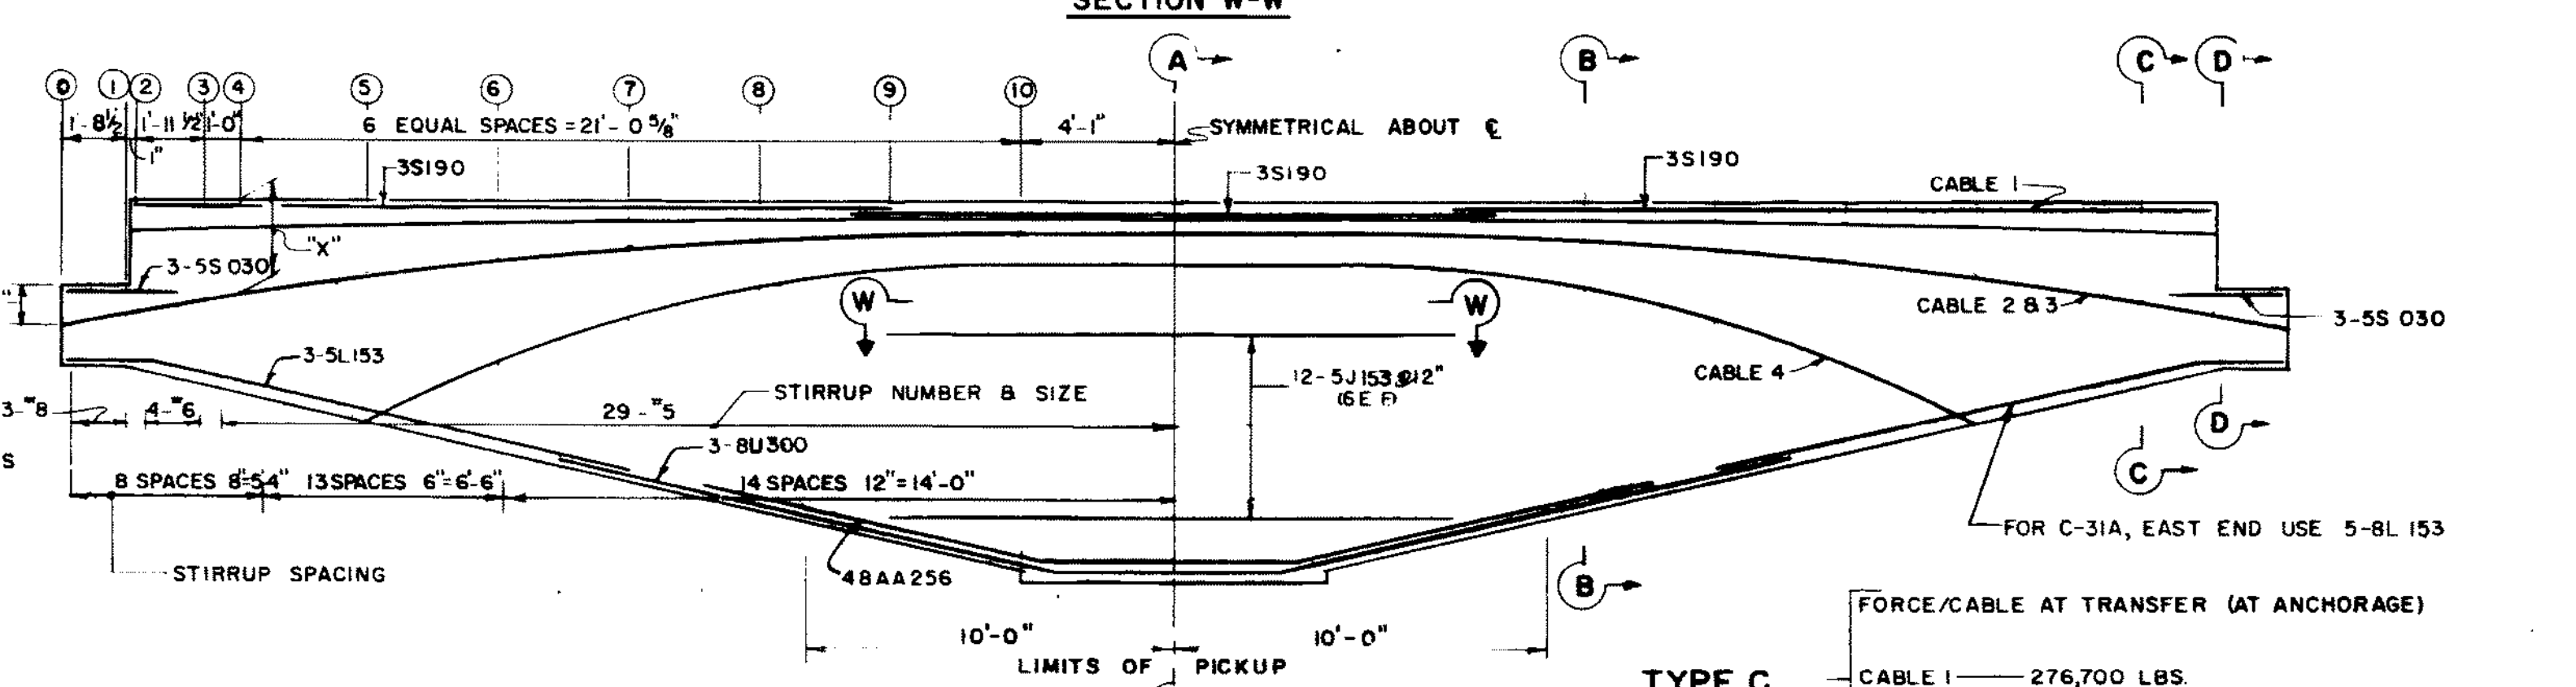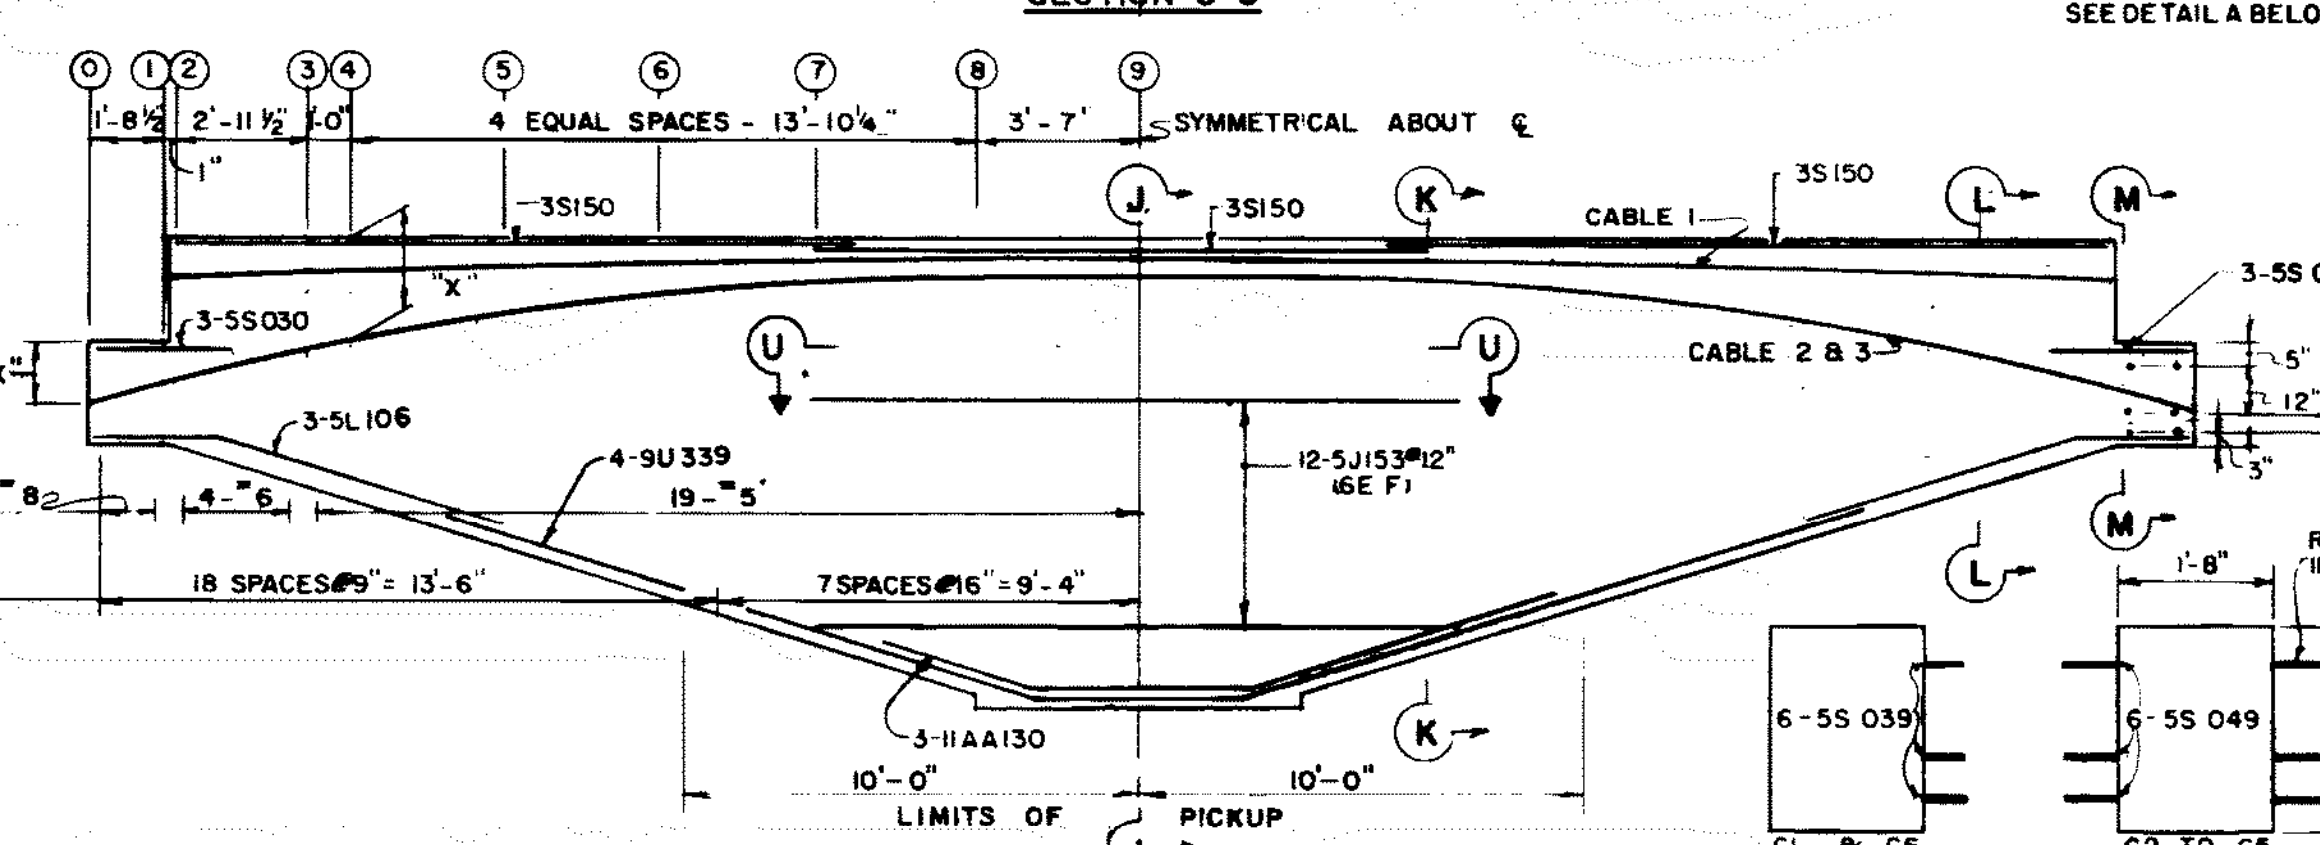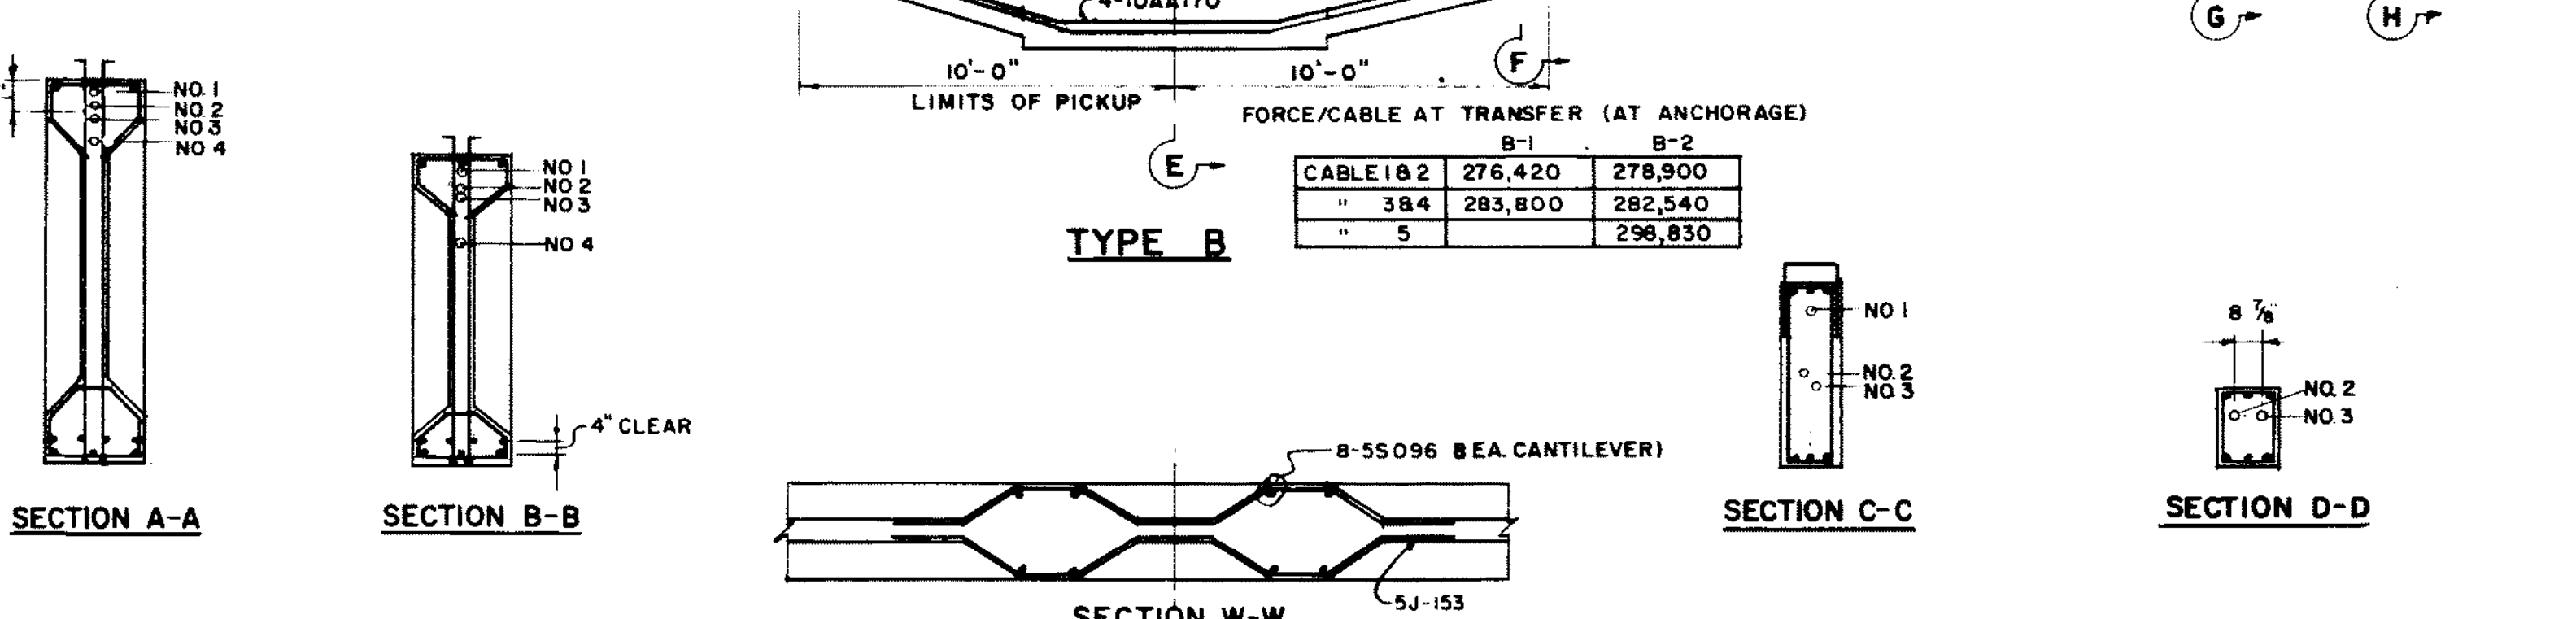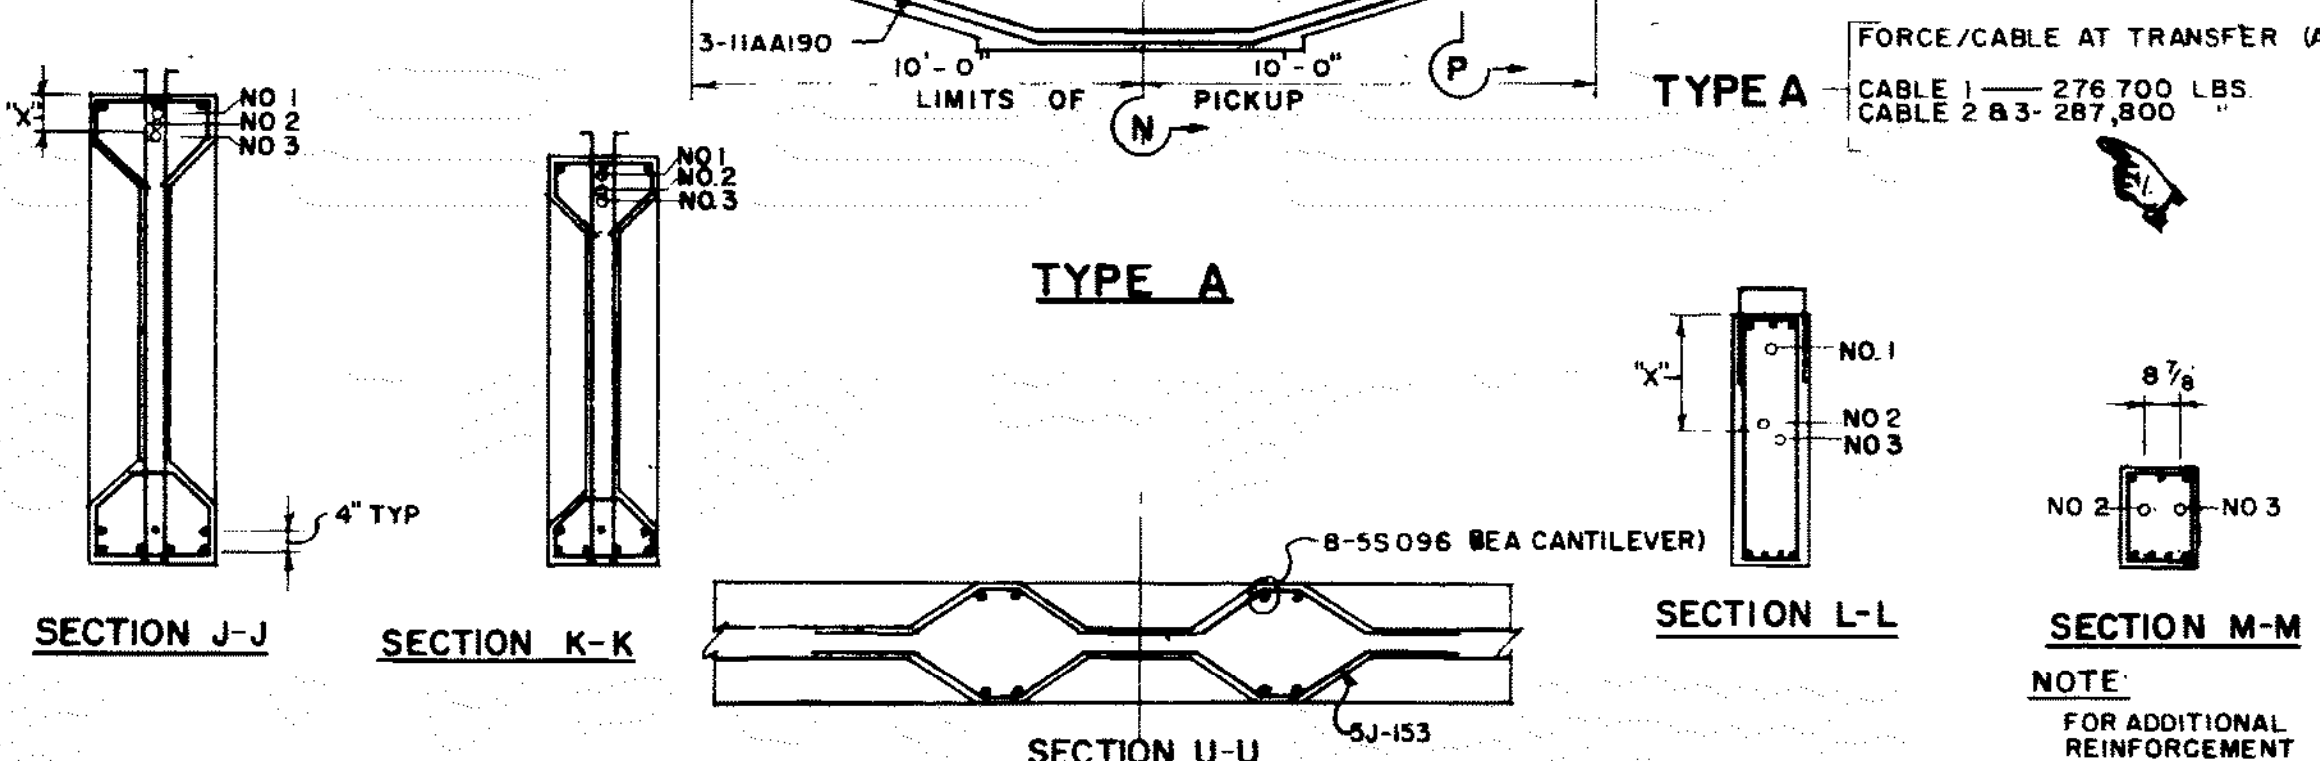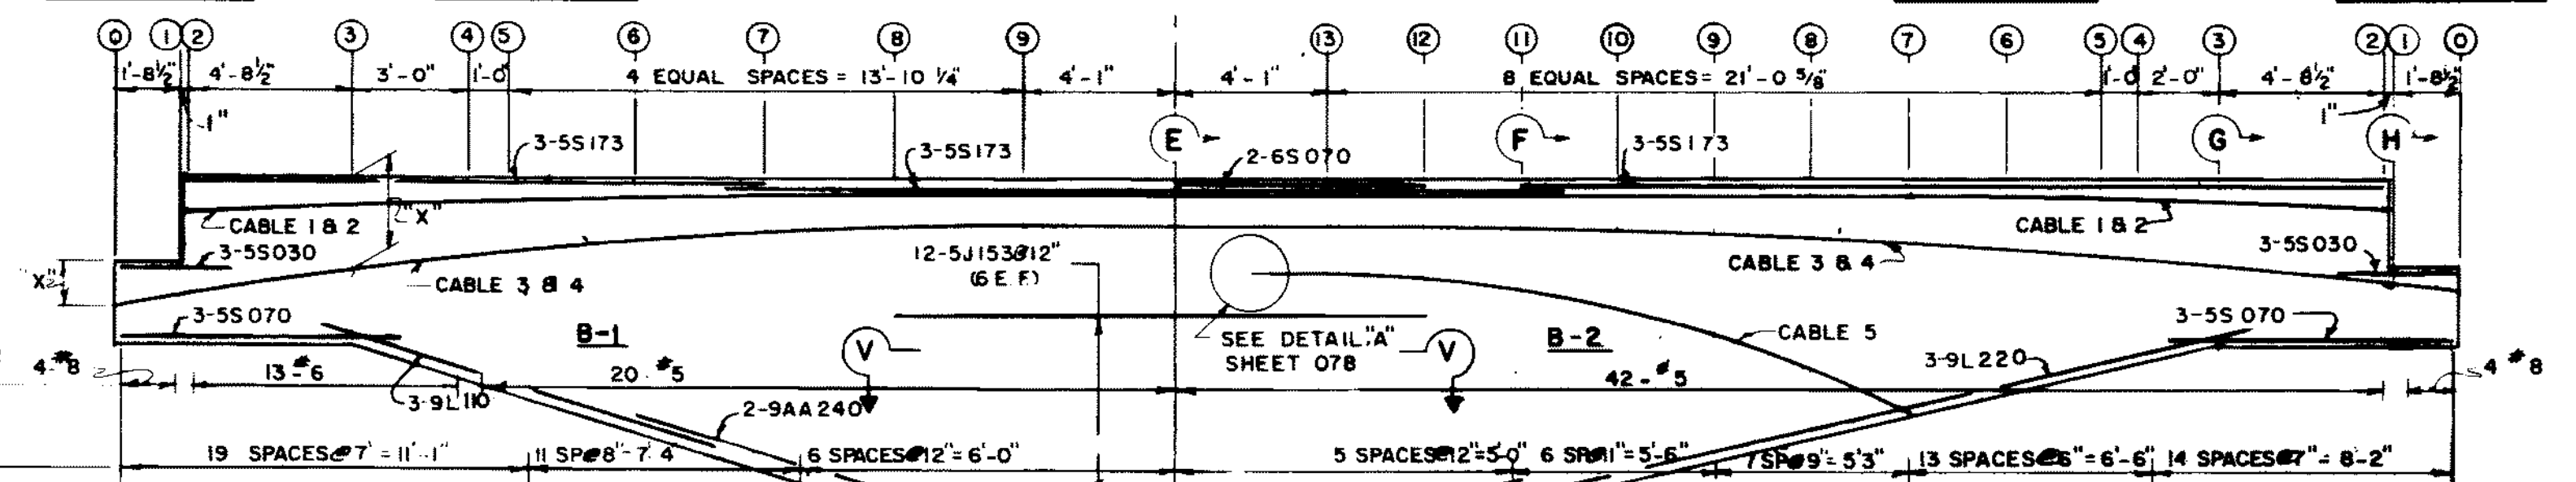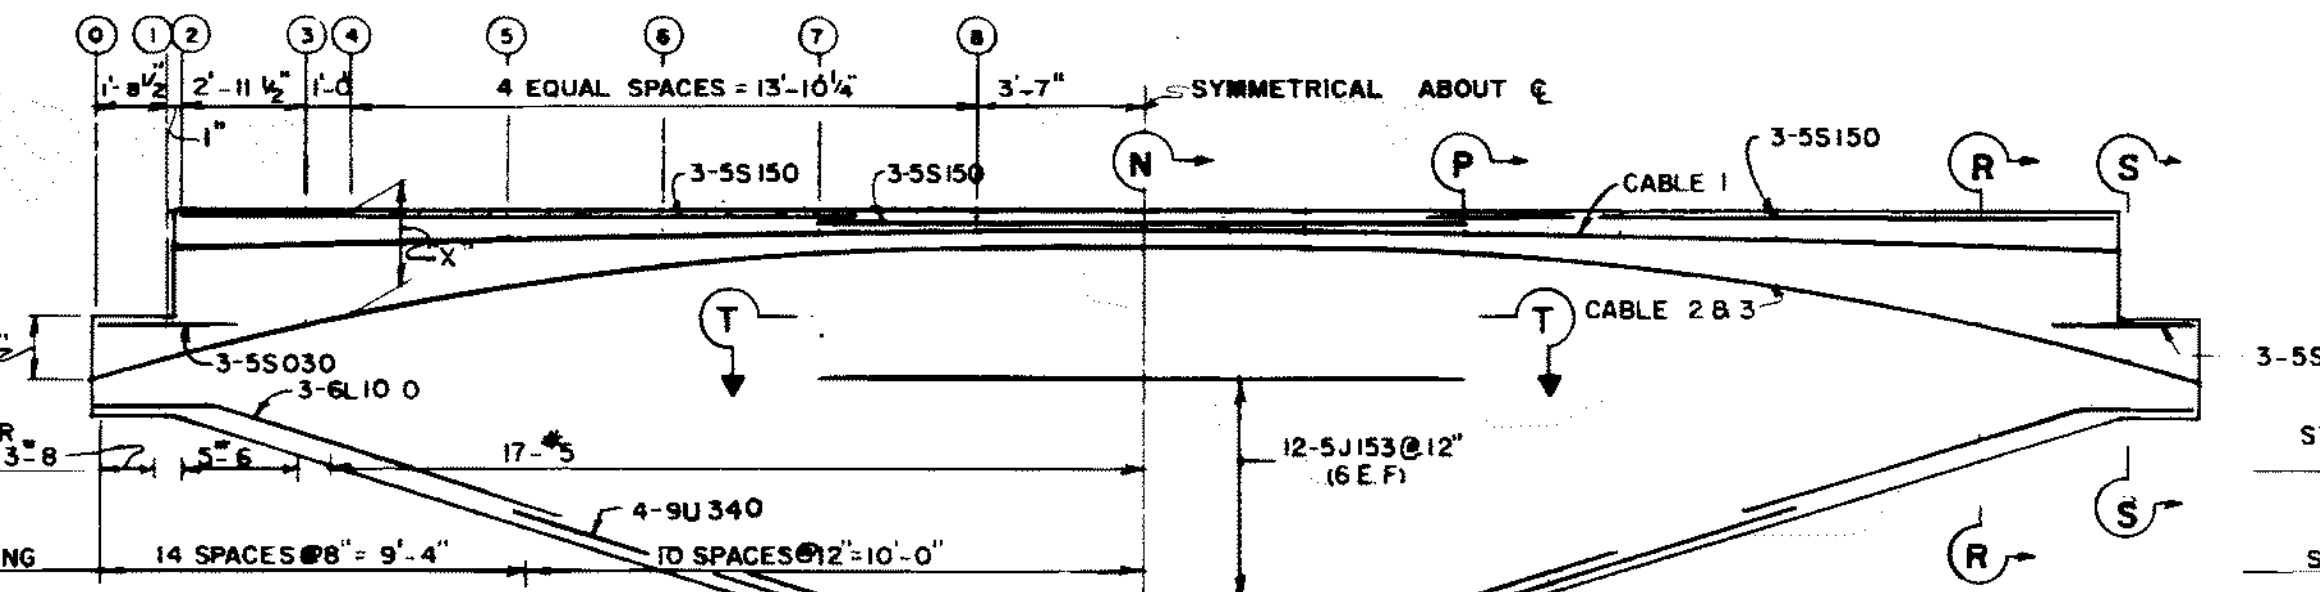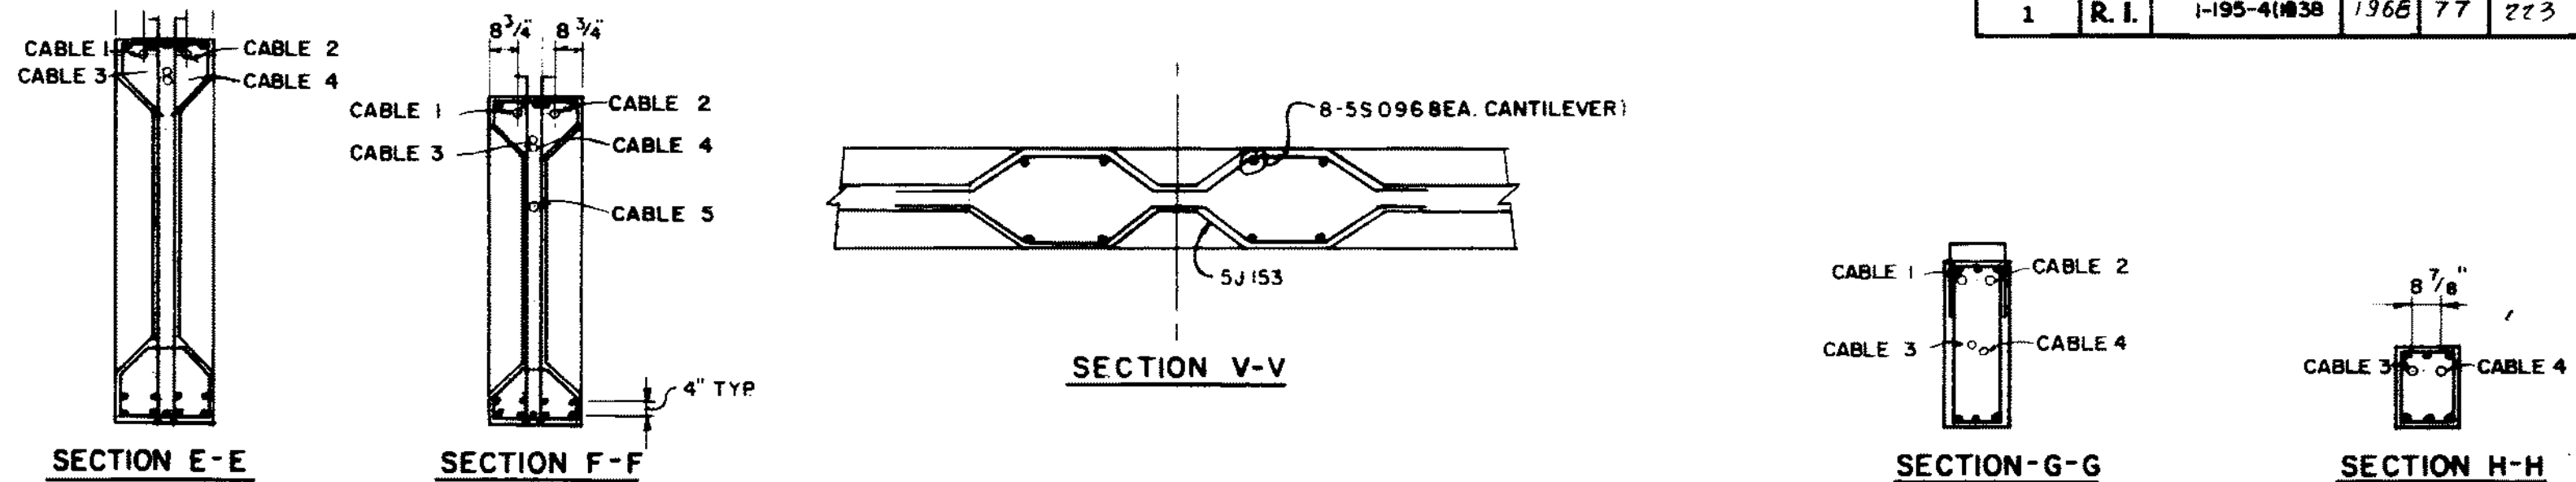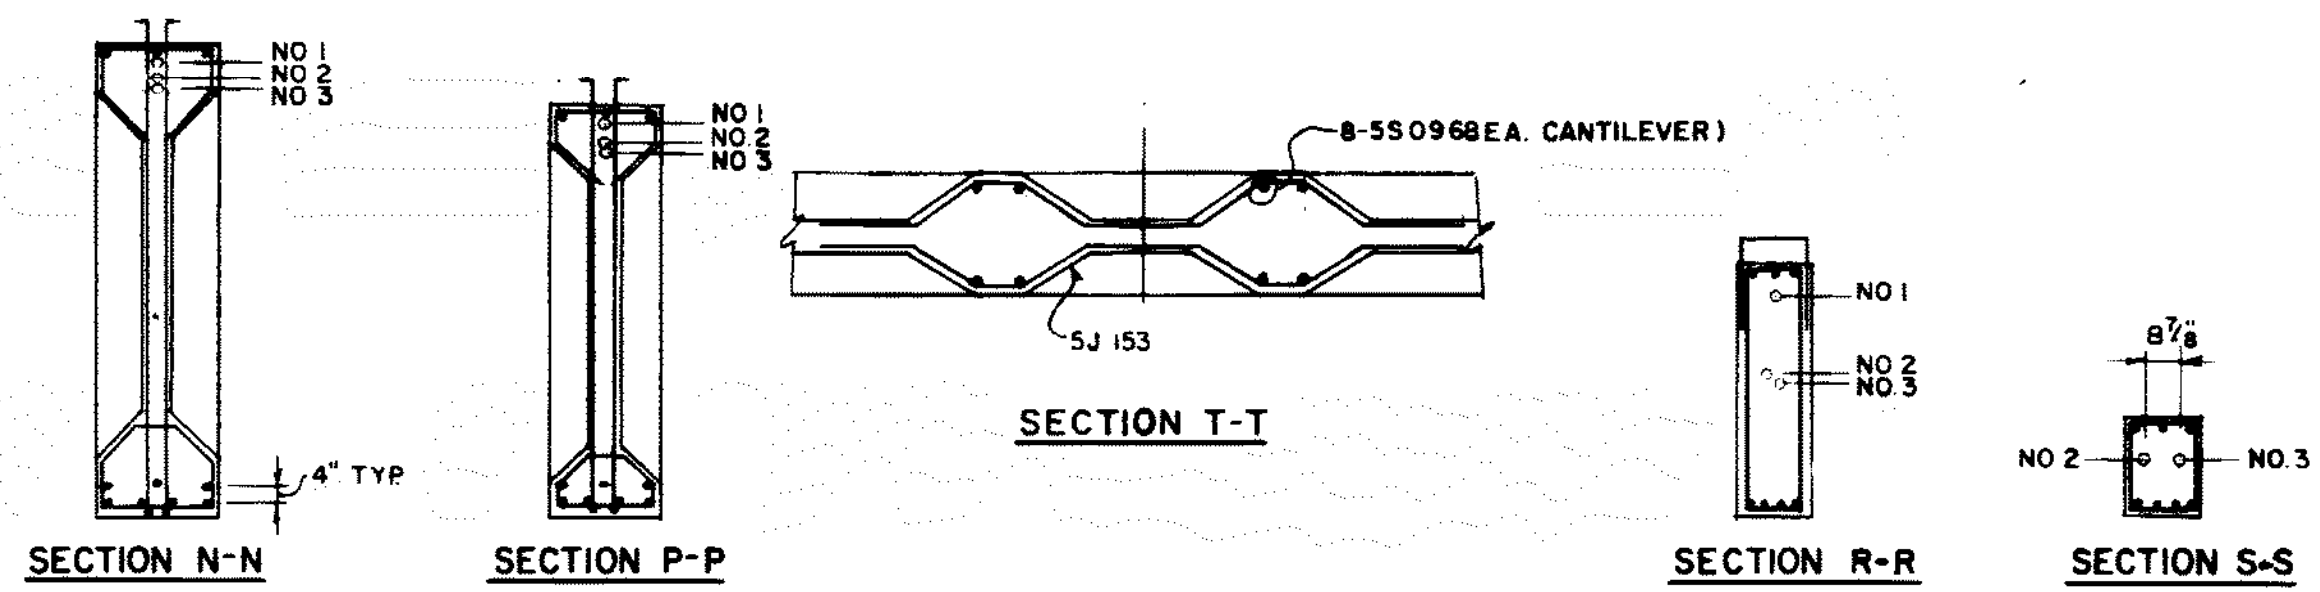

| LOC | "x"           |
|-----|---------------|
| 0   | 16 3/4        |
| 1   | 11            |
| 2   | 10 3/8        |
| 3   | 8 7/16 29 3/8 |
| 4   | 8 26 7/8      |
| 5   | 6 7/8 19 1/2  |
| 6   | 5 3/4 14 1/4  |
| 7   | 5 3/16 11 1/8 |
| 8   | 5 10          |

| LOC | "x"           |
|-----|---------------|
| 0   | 15 3/4        |
| 1   | 11            |
| 2   | 10 3/8        |
| 3   | 8 7/16 30 3/4 |
| 4   | 8 5/16 28 1/2 |
| 5   | 7 7/8 21 7/8  |
| 6   | 6 3/16 16 3/4 |
| 7   | 5 7/16 13     |
| 8   | 5 1/8 10 3/4  |
| 9   | 5 10          |

| LOC | "x"            |
|-----|----------------|
| 0   | 14 1/8         |
| 1   | 11             |
| 2   | 10 3/8         |
| 3   | 8 1/8 29 7/8   |
| 4   | 7 3/16 24 9/16 |
| 5   | 6 7/8 23 7/8   |
| 6   | 6 1/8 19 7/8   |
| 7   | 5 1/2 17 3/16  |
| 8   | 5 1/8 15 3/16  |
| 9   | 5 15           |

| LOC | "x"               |
|-----|-------------------|
| 0   | 10 1/2            |
| 1   | 8                 |
| 2   | 10 3/8            |
| 3   | 7 28 7/8          |
| 4   | 6 3/16 26 3/4     |
| 5   | 5 9/16 25 9/16    |
| 6   | 5 3/8 23 7/8      |
| 7   | 5 21 76 1/8       |
| 8   | 5 19 3/16 62 7/8  |
| 9   | 5 17 1/16 50 3/4  |
| 10  | 5 16 1/2 41 7/8   |
| 11  | 5 15 1/16 35 3/16 |
| 12  | 5 15 3/16 31 7/8  |
| 13  | 5 15 30           |

| LOC | "x"                   |
|-----|-----------------------|
| 0   | 12 9/16               |
| 1   | 8                     |
| 2   | 10 3/8                |
| 3   | 9 7/16 31 7/8         |
| 4   | 8 3/8 29 1/16         |
| 5   | 7 1/16 23 7/8 71 7/8  |
| 6   | 6 1/16 18 7/8 53 3/16 |
| 7   | 5 7/16 15 38 1/16     |
| 8   | 5 7/16 12 1/4 28 3/16 |
| 9   | 5 7/8 10 7/16 22 1/8  |
| 10  | 5 10 20               |

NOTE:  
1 ALL DIMENSIONS IN INCHES  
2 FOR ANCHORAGE DETAILS SEE SHEET 078  
3 SEE NOTES ON SHEET 078.

TYPE A-I  
FORCE/CABLE AT TRANSFER (AT ANCHORAGE)  
CABLE 1 — 276,210 LBS.  
CABLE 2 & 3 — 286,100 LBS.

NOTE:  
SEE SHEET 078 FOR  
STIRRUP DETAILS

| NO. | DATE    | BY   |
|-----|---------|------|
| 1.  | 6/23/67 | R.C. |

RHODE ISLAND  
DEPARTMENT OF PUBLIC WORKS  
DIVISION OF ROADS AND BRIDGES  
WASHINGTON BRIDGE (NORTH)  
CROSSING SEEKONK RIVER  
PROVIDENCE - EAST PROVIDENCE, RHODE ISLAND

CANTILEVERS  
SHEET-4

CHARLES A. MAGUIRE & ASSOCIATES  
ENGINEERS  
PROVIDENCE, R. I.  
DATE: JUN 1967  
SCALE: 1/4" = 1'-0"  
EXCEPT AS NOTED

APPROVED: \_\_\_\_\_ SET NO. \_\_\_\_\_  
SUPERVISING CIVIL ENGINEER (BRIDGE) PRINTED  
APPROVED: \_\_\_\_\_  
CHIEF ENGINEER ISSUED TO \_\_\_\_\_  
FINAL DATE \_\_\_\_\_

**NOTES**

1. FC = 5,000 PSI TYPICAL FOR ALL CANTILEVERS EXCEPT TYPE B. FOR TYPE B USE FC = 6,000 PSI.
2. NO POST TENSIONING ALLOWED UNTIL SPECIFIED COMPRESSIVE STRENGTH IS REACHED. (NOTE 1.)
3. ALL CABLES ARE OF 12-1/2" Ø STRANDS
4. ALTERNATE ANCHORAGE SYSTEM MAY BE USED (SUBJECT TO APPROVAL OF THE ENGINEER) BUT TYPE, NUMBER, AND LOCATIONS OF CABLES MAY NOT BE ALTERED.
5. FORCES SHOWN FOR CABLES DO NOT INCLUDE ANCHORAGE LOSSES.
6. CABLES ARE TO BE TENSIONED FROM BOTH ENDS (EXCEPT CABLE 5, TYPE B).
7. ALL TENDONS SHALL BE GROUTED AFTER PRESTRESSING
8. THE CONTRACTOR SHALL SUBMIT SHOP DRAWINGS, COMPUTATIONS OF ALL P/S LOSSES FOR APPROVAL SHALL BE PROVIDED.
9. HANDLING AND TRANSPORTATION PROCEDURES SHOWING COMPUTATIONS OF ANTICIPATED STRESS LEVELS SHALL BE PROVIDED FOR APPROVAL




**TYPE D-1**

| LOC | CABLE 1 | CABLE 2 & 3 | CABLE 4  | CABLE 5 |
|-----|---------|-------------|----------|---------|
| 0   | —       | 11 3/16     | —        | —       |
| 1   | —       | 8           | —        | —       |
| 2   | 10      | 3 5/8       | —        | —       |
| 3   | 9 3/8   | 34 1/8      | —        | —       |
| 4   | 9 1/8   | 30 3/4      | —        | —       |
| 5   | 8 13/16 | 29 5/8      | —        | —       |
| 6   | 7 13/16 | 24 1/8      | 7 7/8    | —       |
| 7   | 6 7/16  | 19 13/16    | 55 1/8   | —       |
| 8   | 6 1/4   | 16 3/16     | 41 7/16  | 9 1/8   |
| 9   | 5 7/16  | 13 3/16     | 30 13/16 | 65 7/8  |
| 10  | 5 3/16  | 11 3/16     | 23 3/16  | 47 3/4  |
| 11  | 5 1/16  | 10 7/16     | 18 3/16  | 36 3/4  |
| 12  | 5       | 10          | 17       | 33      |

**TYPE D-2**


| LOC | CABLE 1 | CABLE 2 & 3 | CABLE 4 | CABLE 5 |
|-----|---------|-------------|---------|---------|
| 0   | 14 9/16 | 29 3/8      | —       | —       |
| 1   | 12      | 26          | —       | —       |
| 2   | 12      | 26          | —       | —       |
| 3   | 7 1/16  | 19 9/16     | —       | —       |
| 4   | 6 9/16  | 16 9/16     | —       | —       |
| 5   | 5 13/16 | 15 3/16     | —       | —       |
| 6   | 5       | 12 7/16     | 71 7/8  | —       |
| 7   | 5       | 10 9/8      | 55 1/8  | —       |
| 8   | 5       | 10          | 41 7/16 | 91 1/8  |
| 9   | 5       | 10          | 30 9/16 | 65 7/8  |
| 10  | 5       | 10          | 23 3/16 | 47 3/4  |
| 11  | 5       | 10          | 18 3/16 | 36 3/4  |
| 12  | 5       | 10          | 17      | 33      |

NOTE ALL DIMENSIONS IN INCHES

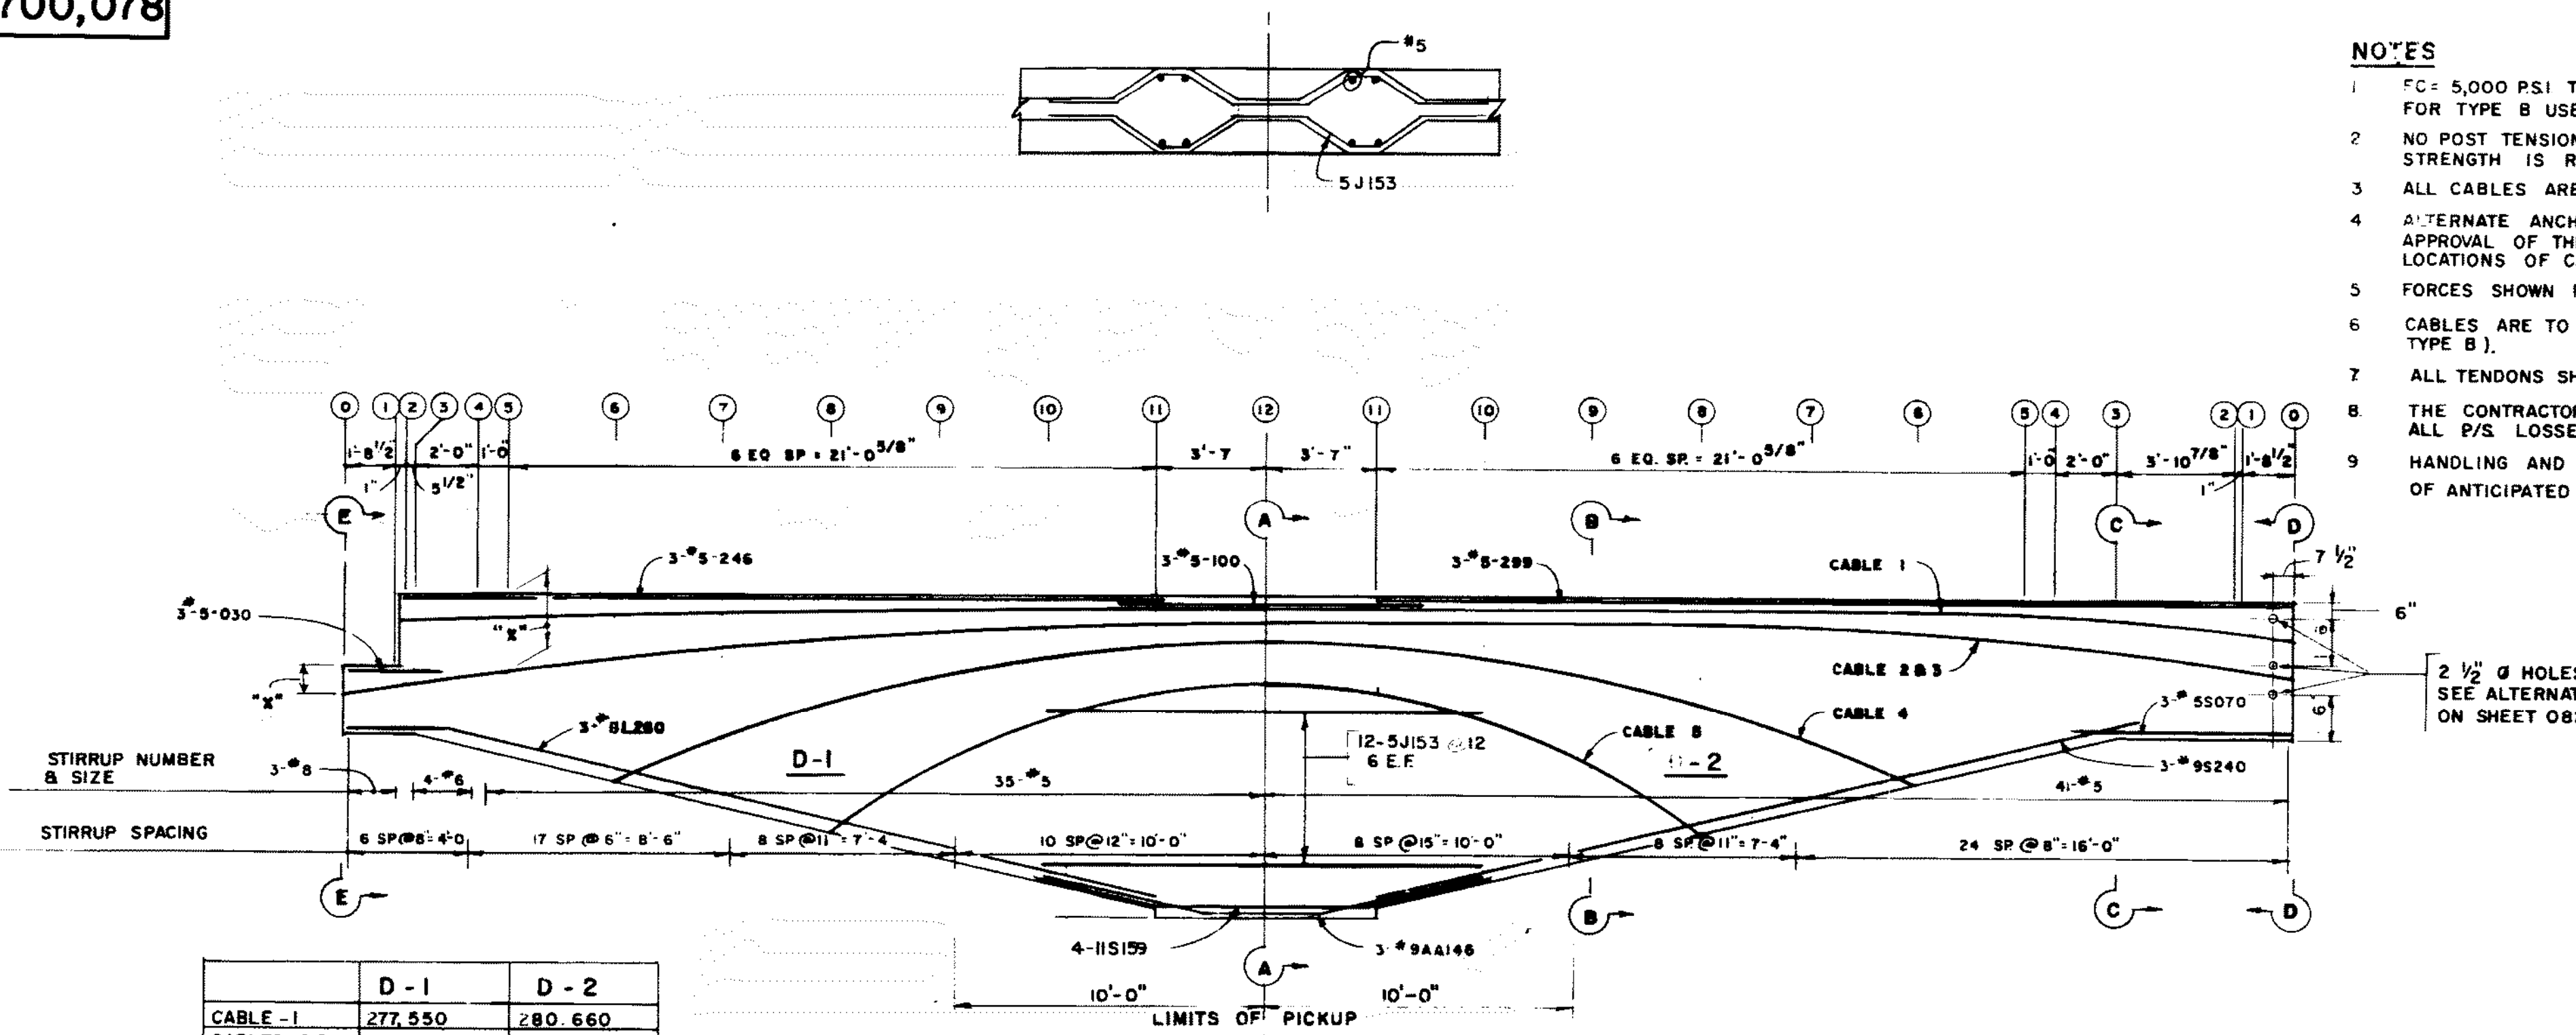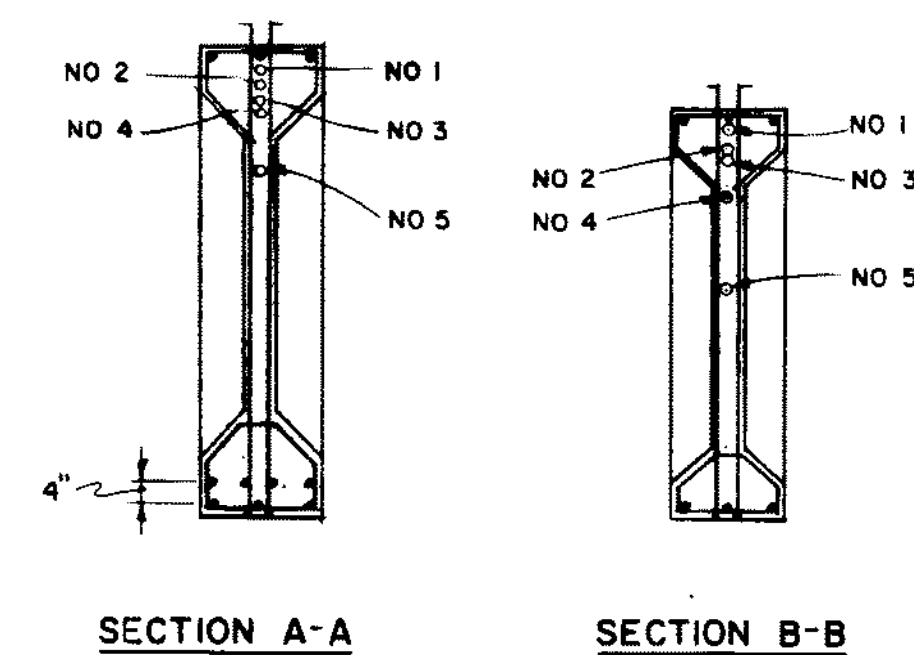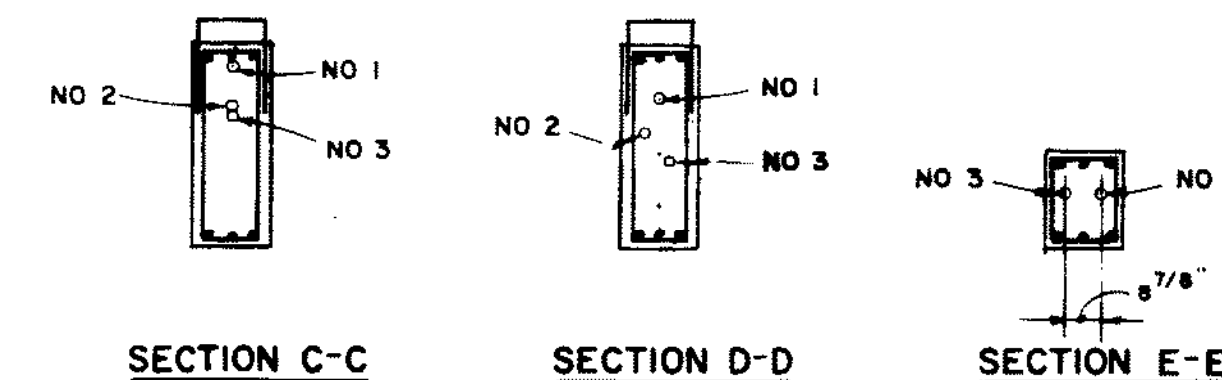


|              | D-1     | D-2     |
|--------------|---------|---------|
| CABLE - 1    | 277,550 | 280,660 |
| CABLES 2 & 3 | 284,170 | 283,400 |
| CABLE - 4    | 297,490 | 297,490 |
| CABLE - 5    | 307,170 | 307,170 |

**TYPE D**

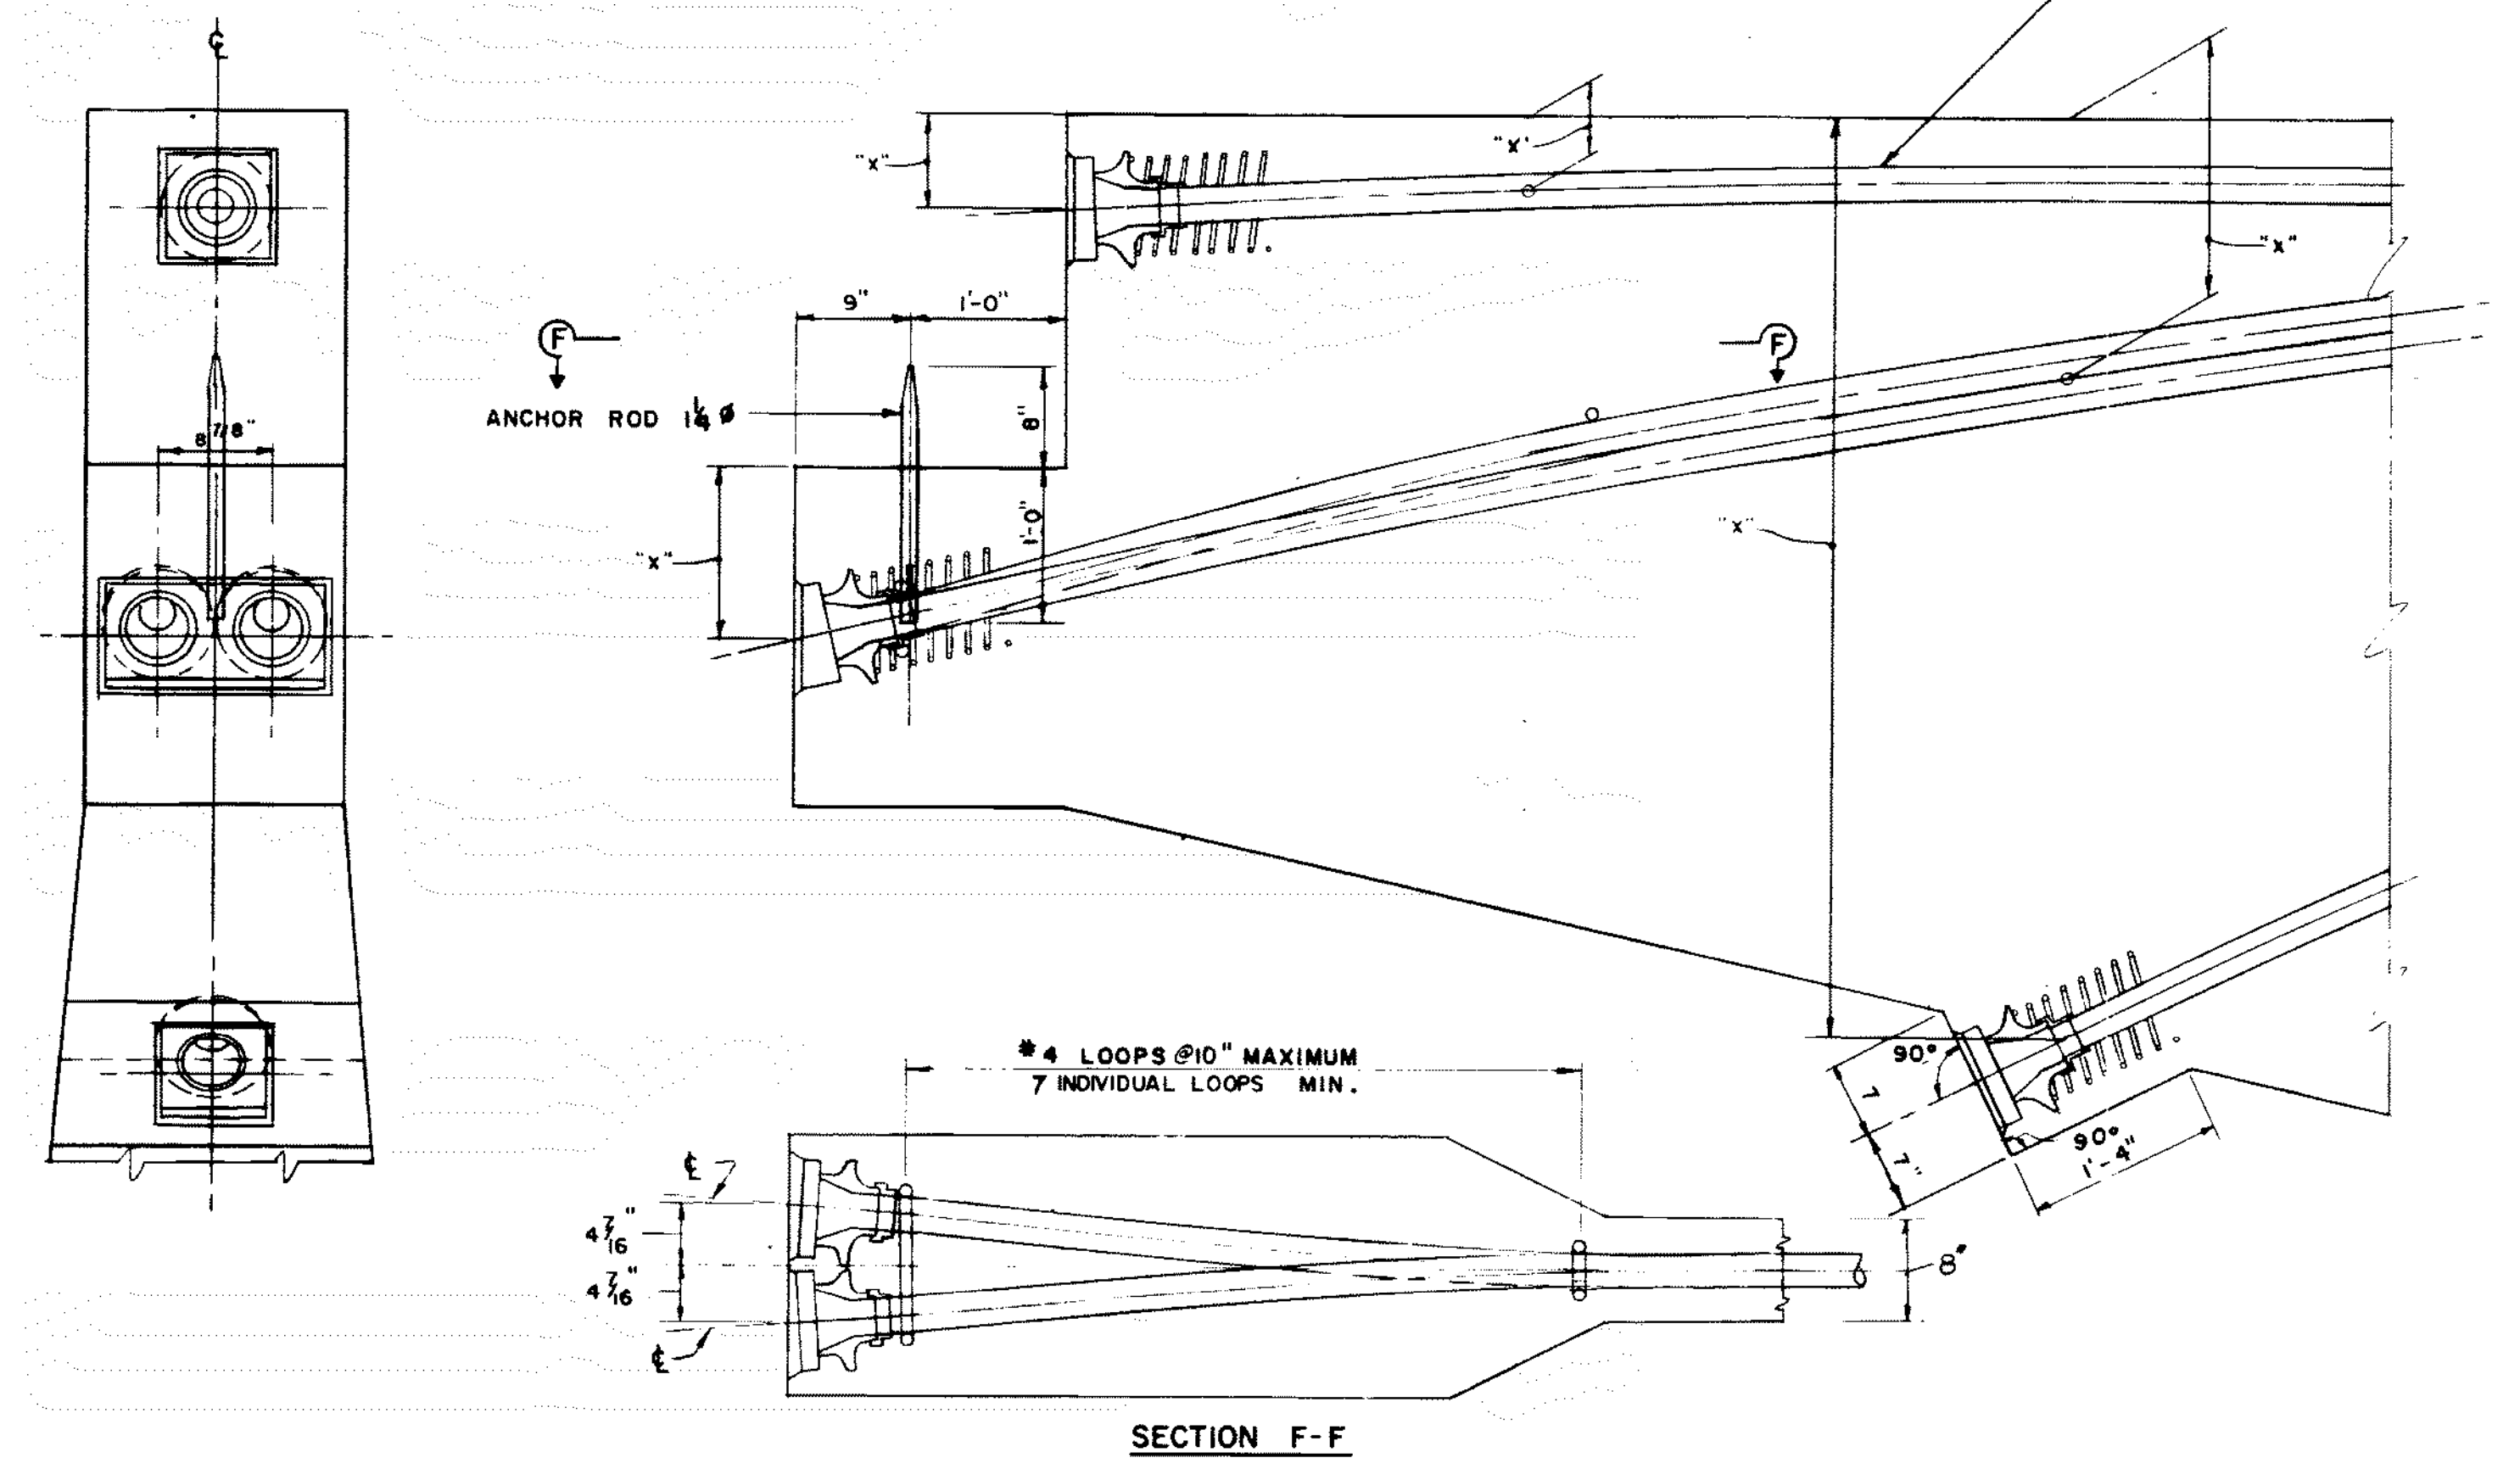


**ANCHORAGE DETAILS**


SCALE: 1"=1'-0"

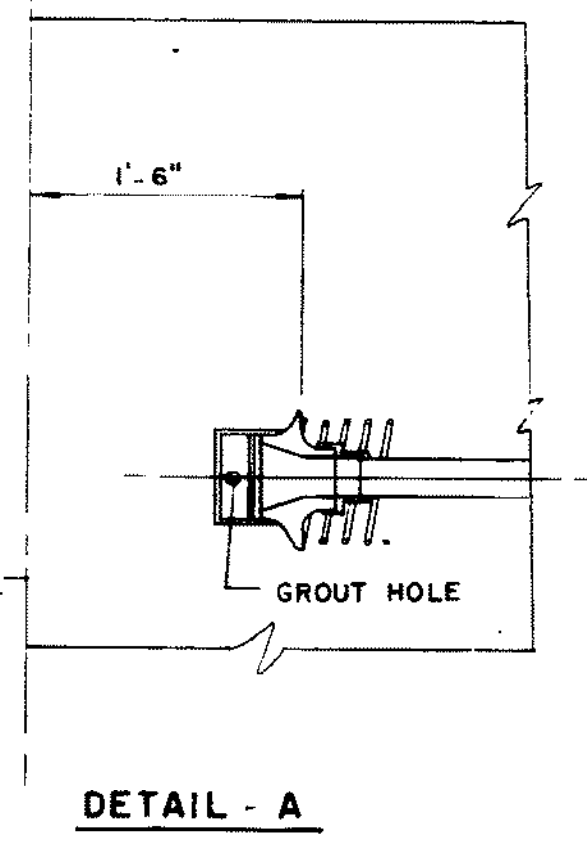

**DETAIL - A**

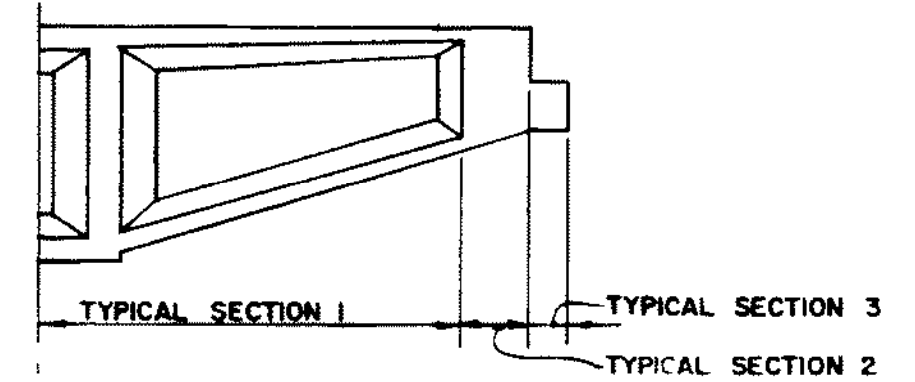


**ELEVATION**

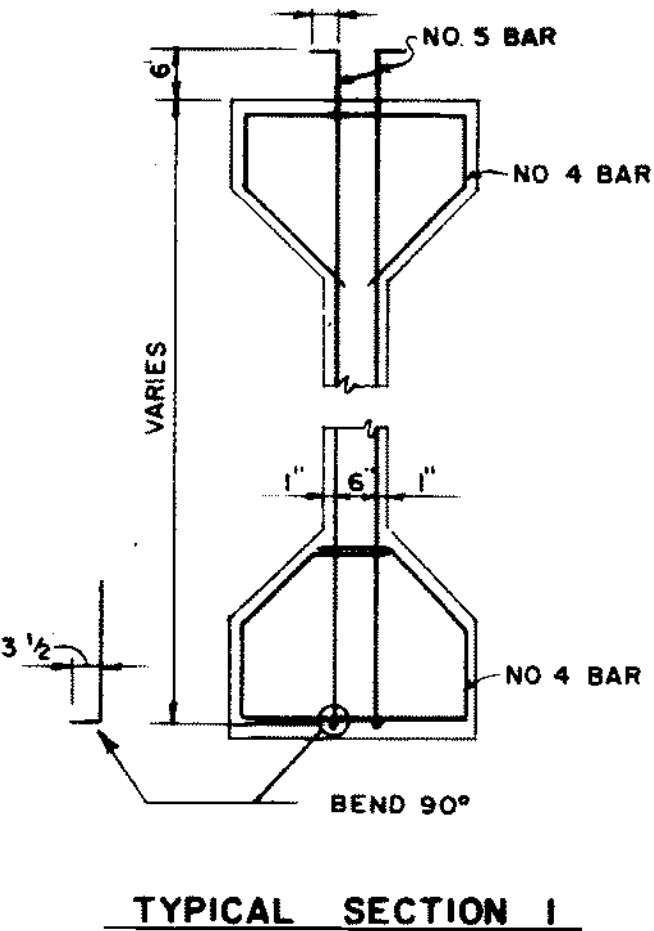


**TYPICAL SECTION 1**

**STIRRUP DETAILS**

NOT TO SCALE

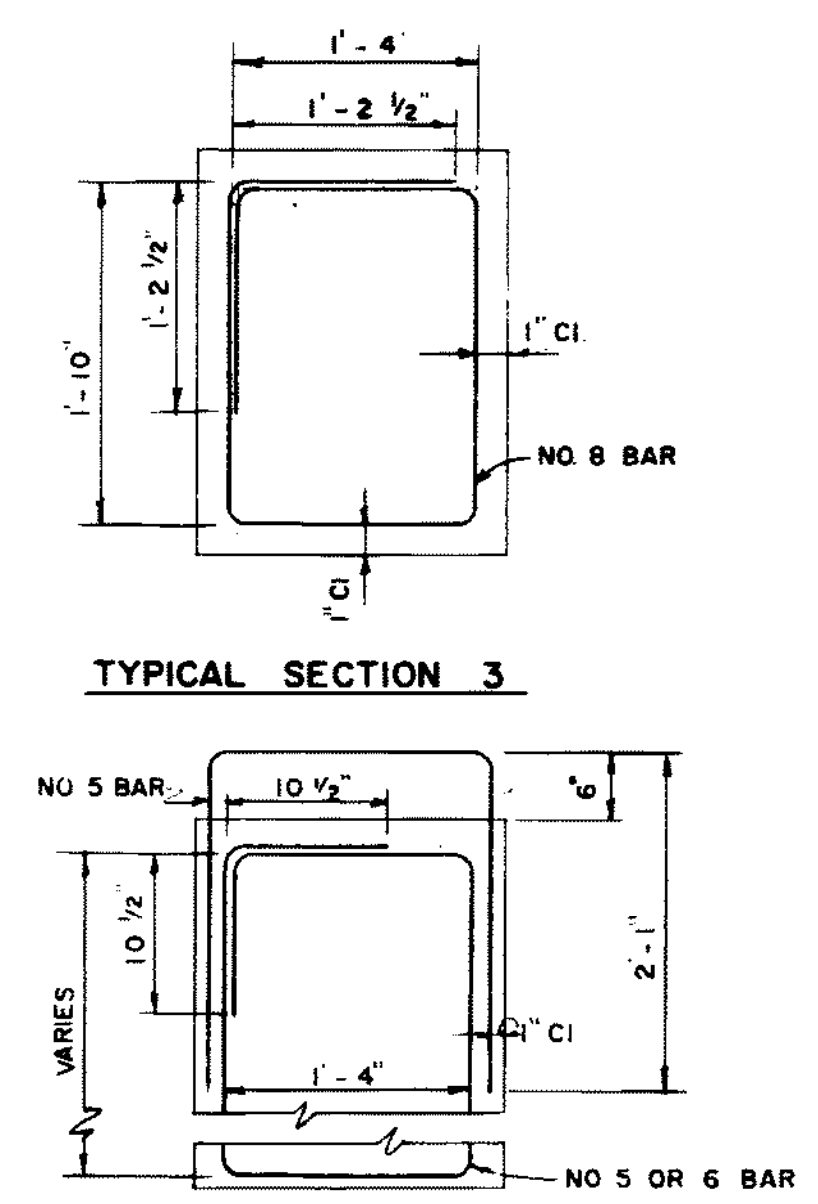

**TYPICAL SECTION 3**

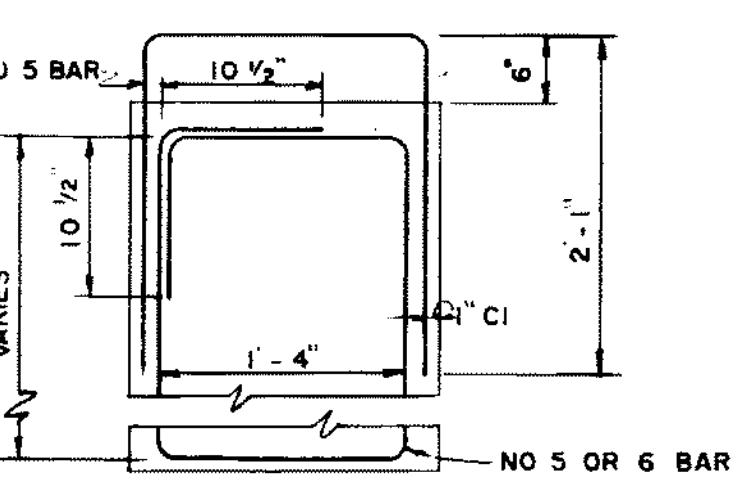

**TYPICAL SECTION 2**

| REVISIONS |      |    |
|-----------|------|----|
| NO.       | DATE | BY |
|           |      |    |
|           |      |    |
RHODE ISLAND  
DEPARTMENT OF PUBLIC WORKS  
DIVISION OF ROADS AND BRIDGES  
**WASHINGTON BRIDGE (NORTH)**  
CROSSING SEEKONK RIVER  
PROVIDENCE - EAST PROVIDENCE, RHODE ISLAND

**CANTILEVERS SHEET-5**


CHARLES A. MAGUIRE & ASSOCIATES  
ENGINEERS  
PROVIDENCE, R. I.  
DATE JAN. 1967  
SCALE 1/4"=1'-0"  
EXCEPT AS NOTED

APPROVED \_\_\_\_\_  
SUPERVISING CIVIL ENGINEER (BRIDGE)  
PRINTED \_\_\_\_\_  
APPROVED \_\_\_\_\_  
CHIEF ENGINEER  
ISSUED TO \_\_\_\_\_  
FINAL DATE \_\_\_\_\_


**NOTE:**

THE HIGH STRENGTH STEEL TO BE USED FOR ANCHOR PLATES, HOLD DOWN PLATES AND PLATE WASHERS SHOWN ON SHEETS LISTED BELOW SHALL CONFORM TO A S.T.M. DESIGNATION A 107-61T. GRADE 1040 FOR BAR SIZES AND SHALL BE FROM ROLLED BILLETS CONFORMING TO THE SAME DESIGNATION AS WELL AS THE REQUIREMENTS OF A S.T.M. DESIGNATION A-6 FOR PLATE SIZES WITH THE FOLLOWING PHYSICAL REQUIREMENTS:  
 MIN ULTIMATE STRENGTH = 91,000 P.S.I.  
 MIN YIELD POINT = 50,000 P.S.I.


LIST OF DRAWINGS:  
 026, 040, 042, 080,  
 139 & 143

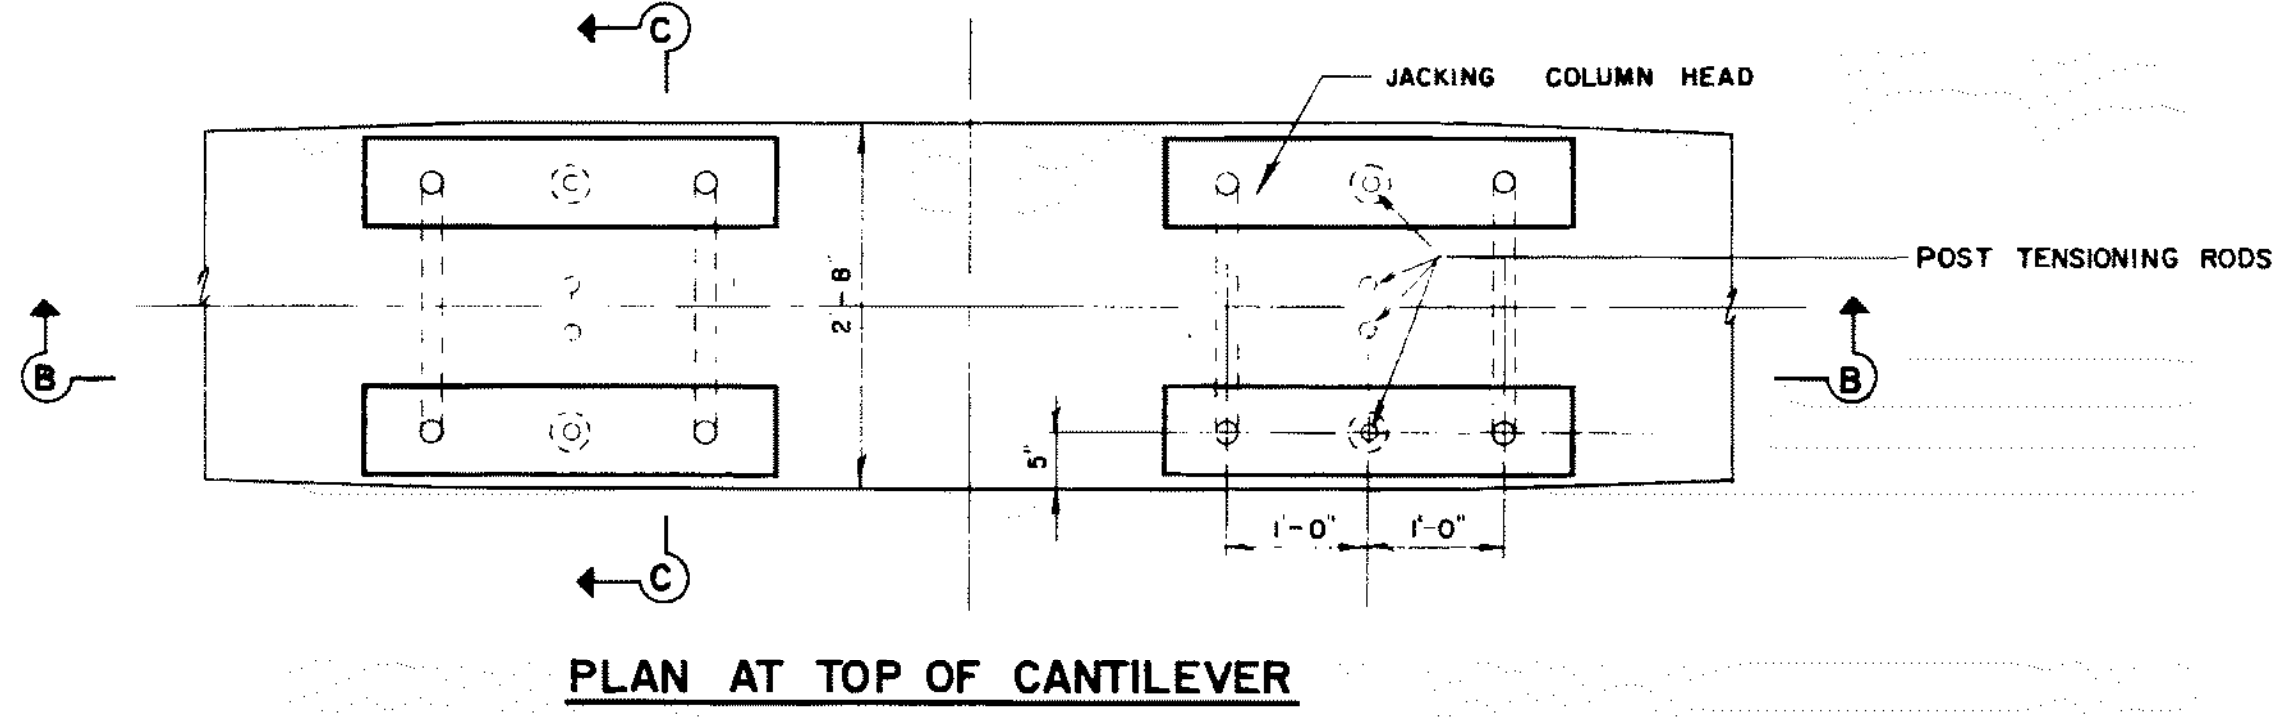


PLAN AT TOP OF CANTILEVER

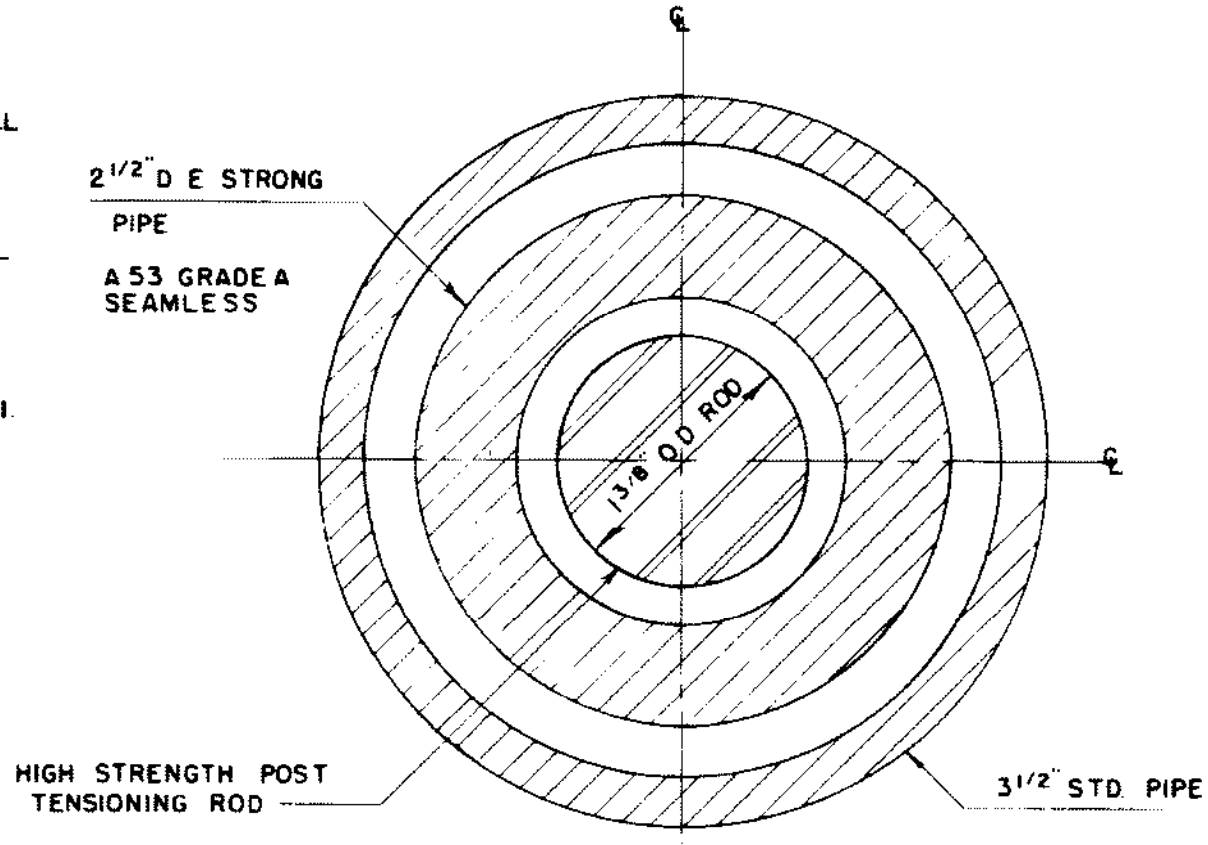

SECTION A-A  
FULL SIZE

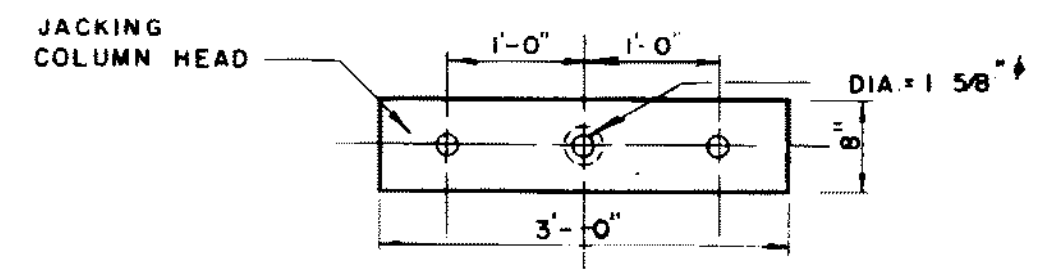


PLAN

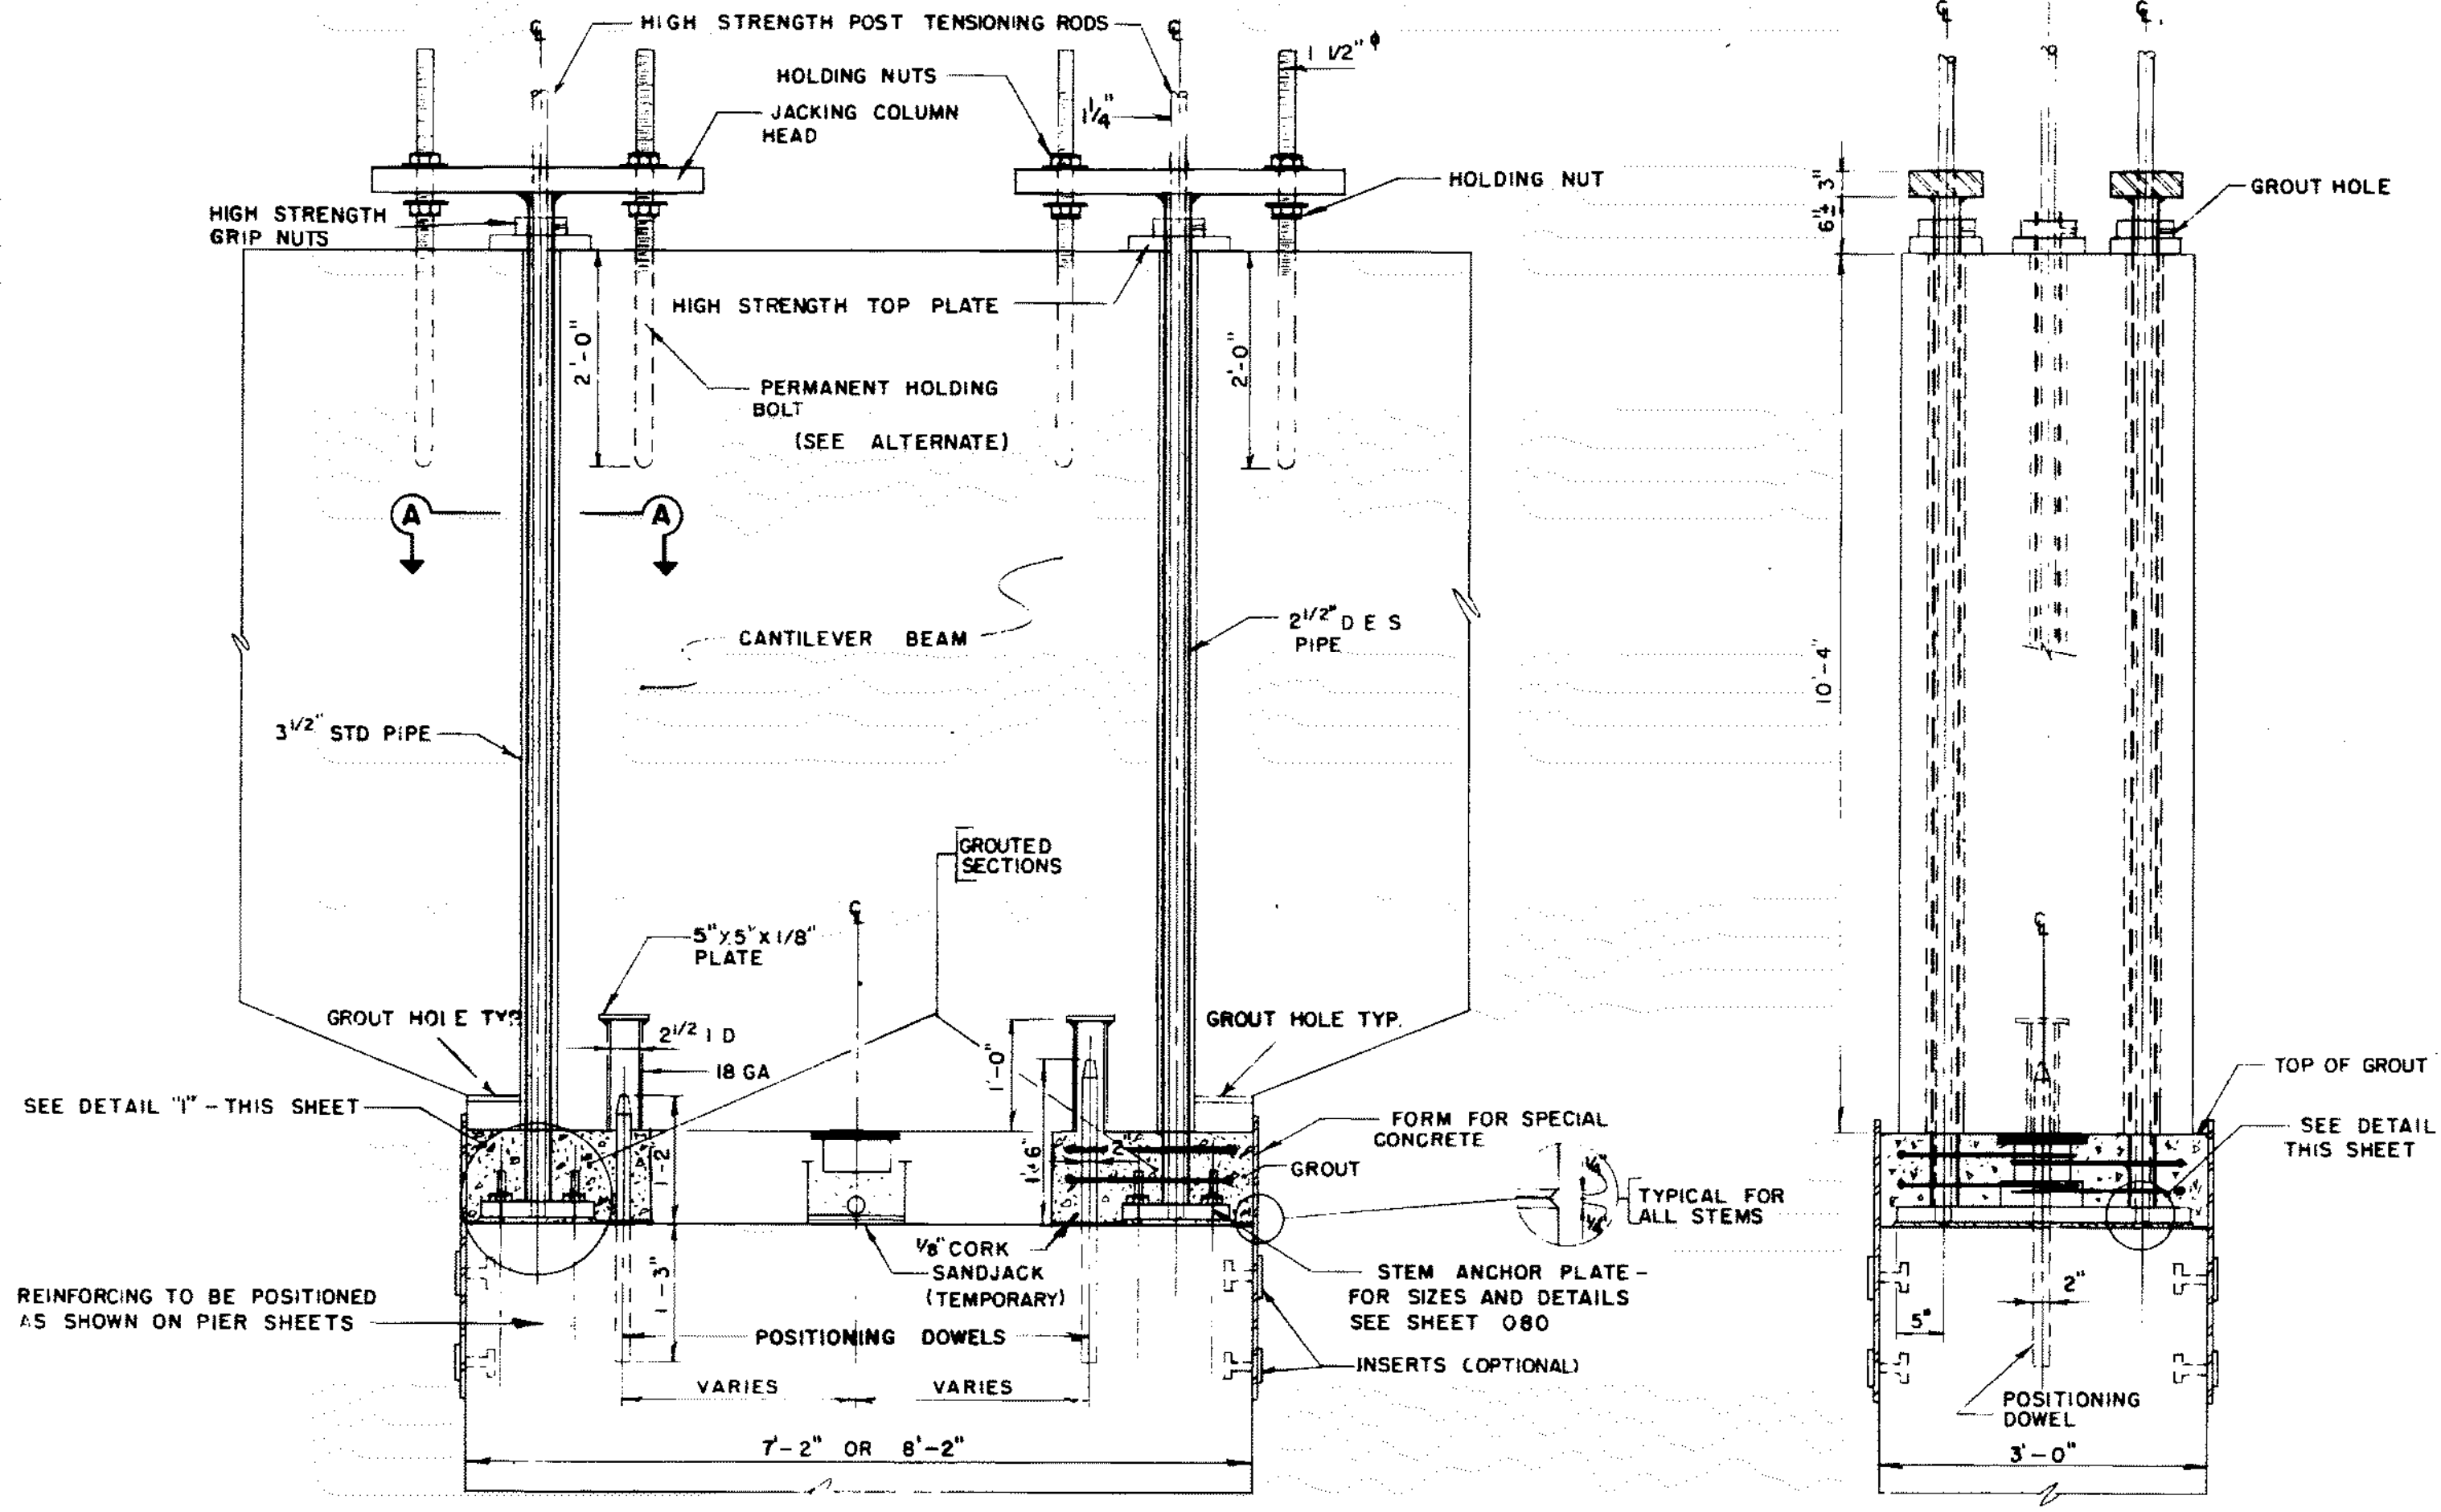


SECTION B-B

SECTION C-C


SECTIONAL VIEWS OF CANTILEVER POSITIONING ASSEMBLY

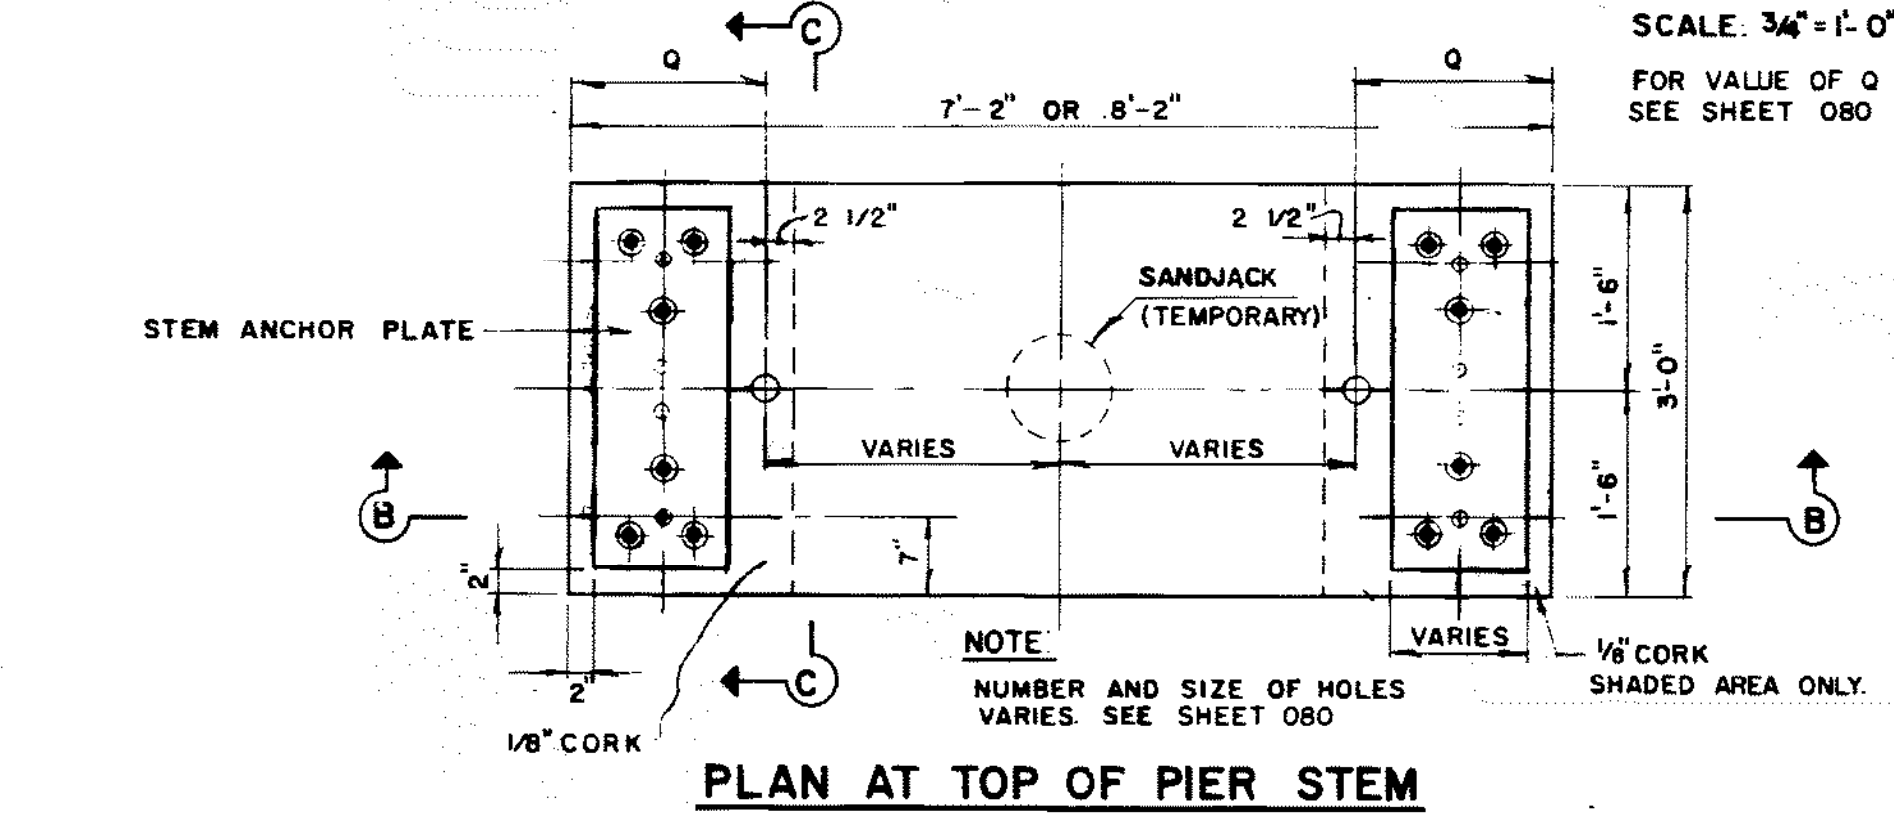


PLAN AT TOP OF PIER STEM

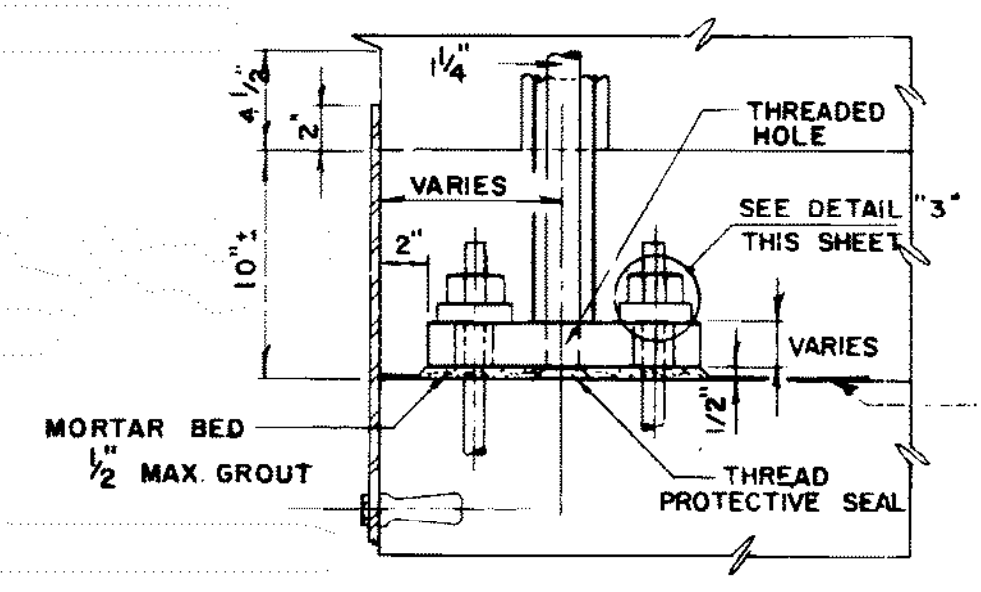


DETAIL '1'

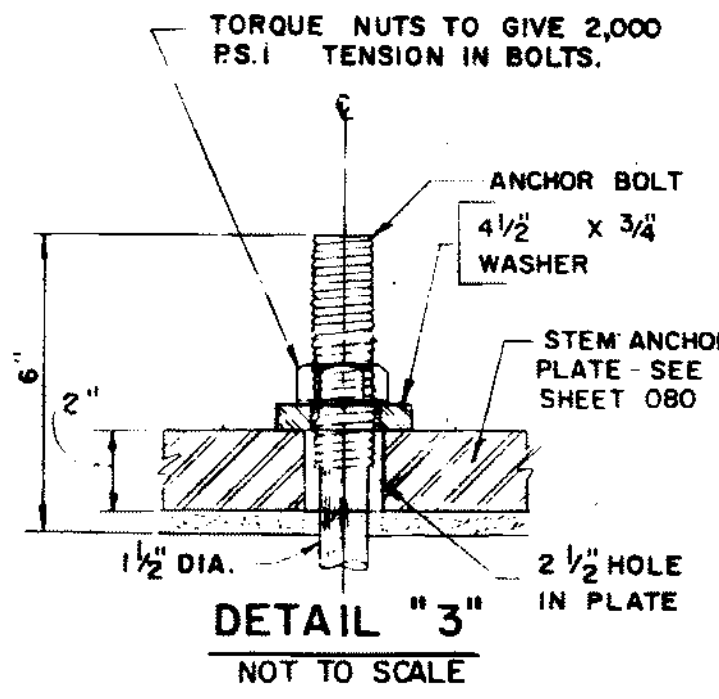

DETAIL '3'

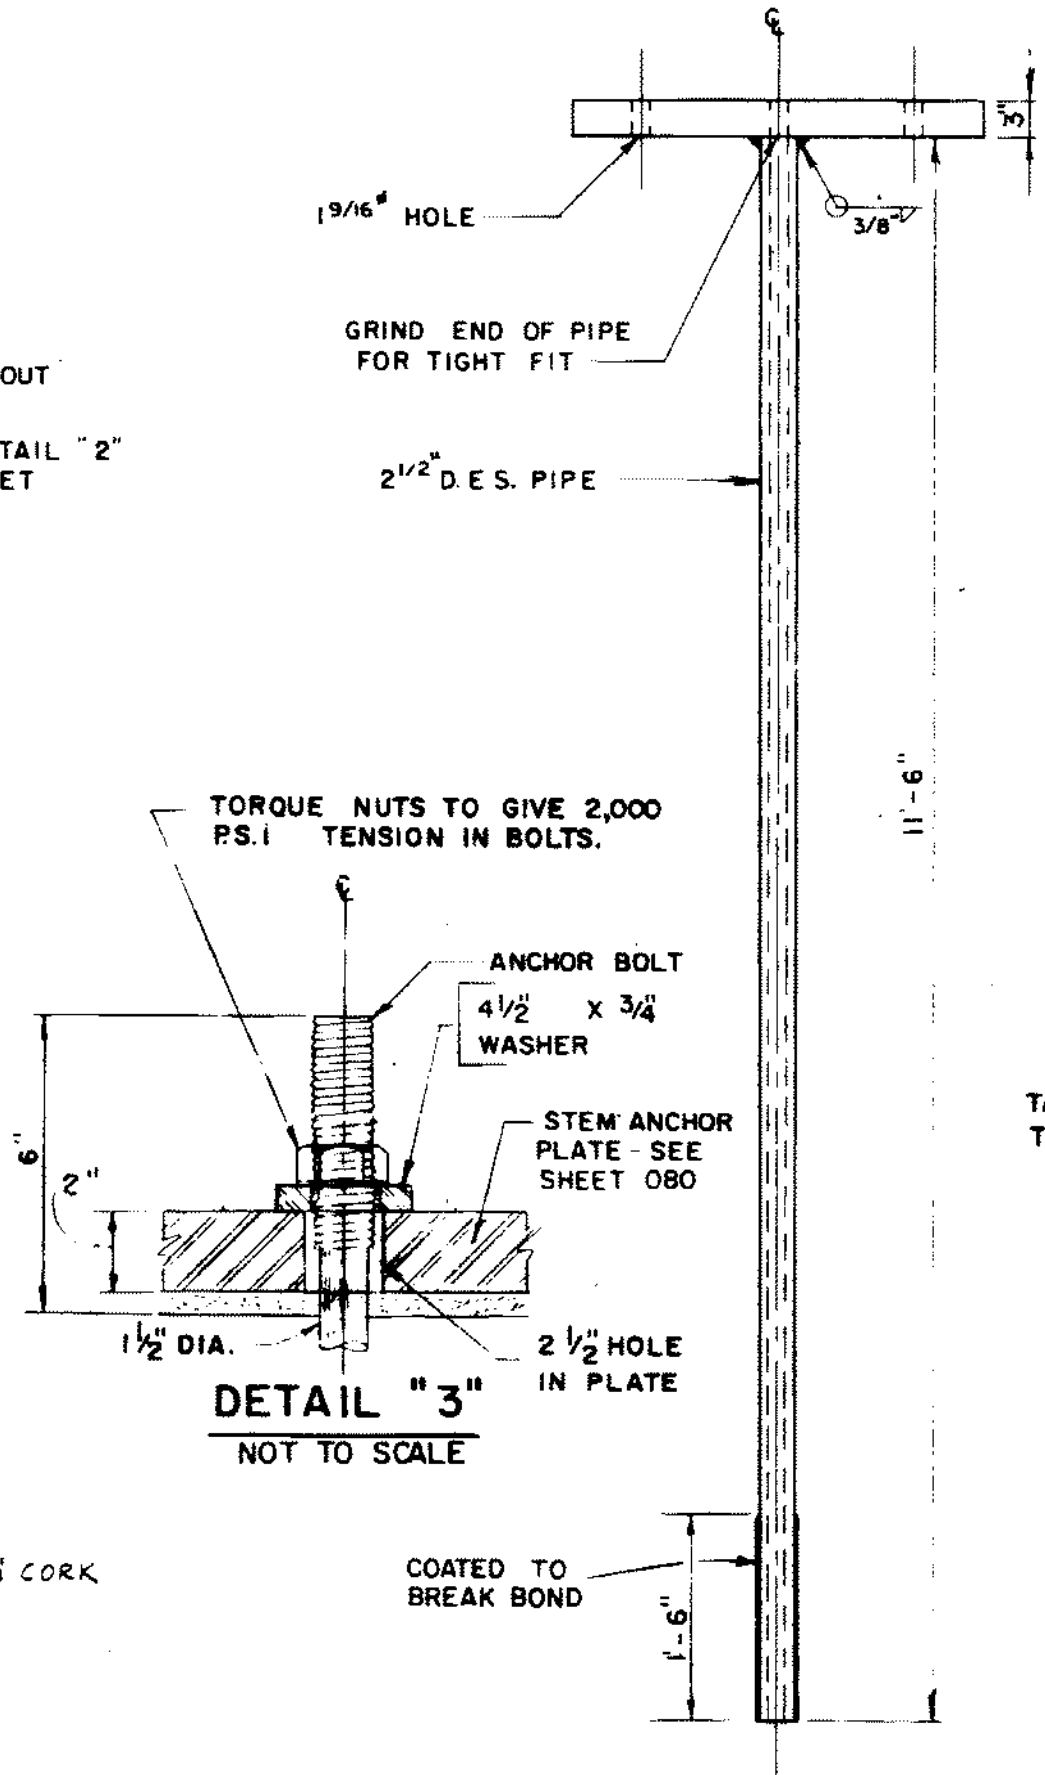

JACKING COLUMN

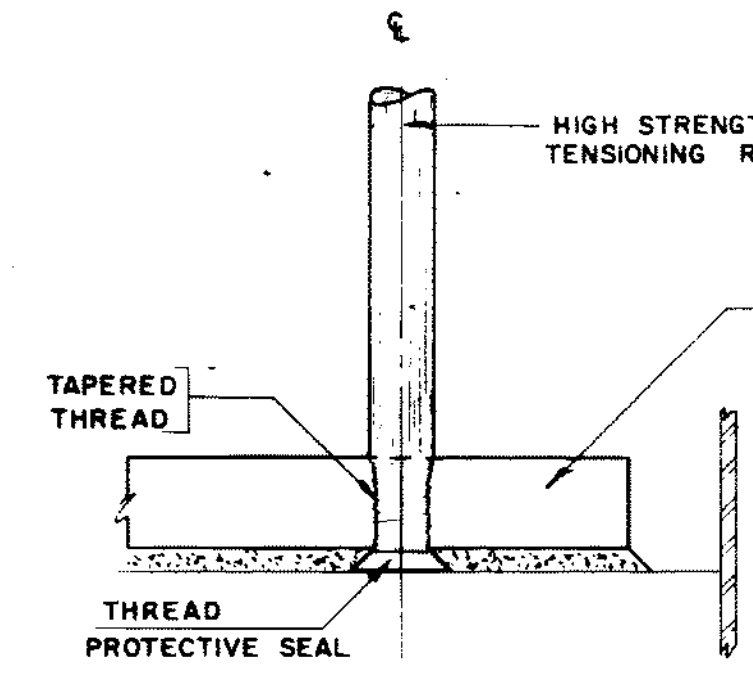

DETAIL '2'


SCALE: 3" = 1'-0"

DESCRIPTION OF SUGGESTED METHOD FOR POSITIONING CANTILEVER BEAMS ON STEMS

1. After the concrete in the pier stem has obtained a minimum strength of 2500 psi compression, place the stem anchor plates over the anchor bolts (Detail 3), level on a 1/2" grout bed. When mortar has acquired sufficient strength, tighten anchor bolt nuts as shown on drawing.
2. Lower the cantilever beam over the positioning dowels, align and seat on sand jack. (Hydraulic jack may be used rather than sand jack)
3. Remove protection from the threaded holes in the stem anchor plates, insert all high strength post tensioning rods and tighten to full extent of thread on the rods. Visually inspect each rod to assure that it is completely seated.
4. Insert jacking columns into corner holes and position on stem anchor plates.
5. Install and tighten holding nuts on temporary jacking column heads.
6. Crane may now be released.
7. Adjust beam to required grade with holding nuts and sand jack.
8. Tighten all holding nuts and block cantilever beam to prevent any further movement.
9. Install forms for Special Concrete grout and place concrete between pier stem and bottom of cantilever, as shown on the plans.
10. Remove jacking columns after concrete described in par.#9 has obtained a strength of not less than 2,500 psi, as measured in ultimate compressive strength test cylinders, prepared and tested as required by the Engineer. Remove sand jack.
11. After concrete as described in par.#9 has obtained a minimum ultimate compressive strength of 4,000 psi as determined by test as required by the Engineer, post tension all high strength rods to loads as specified, anchor and grout.
12. Remove all extraneous material and cut, remove or burn off all hardware extending more than 8 inches above the top of the cantilever beam.
13. Chase threads for re-use, prior to concreting

**NOTE:**

THE METHOD SHOWN HERE IS ONLY A SUGGESTED ONE. THE CONTRACTOR MAY SUBMIT A MODIFIED OR ALTERNATE METHOD FOR APPROVAL.

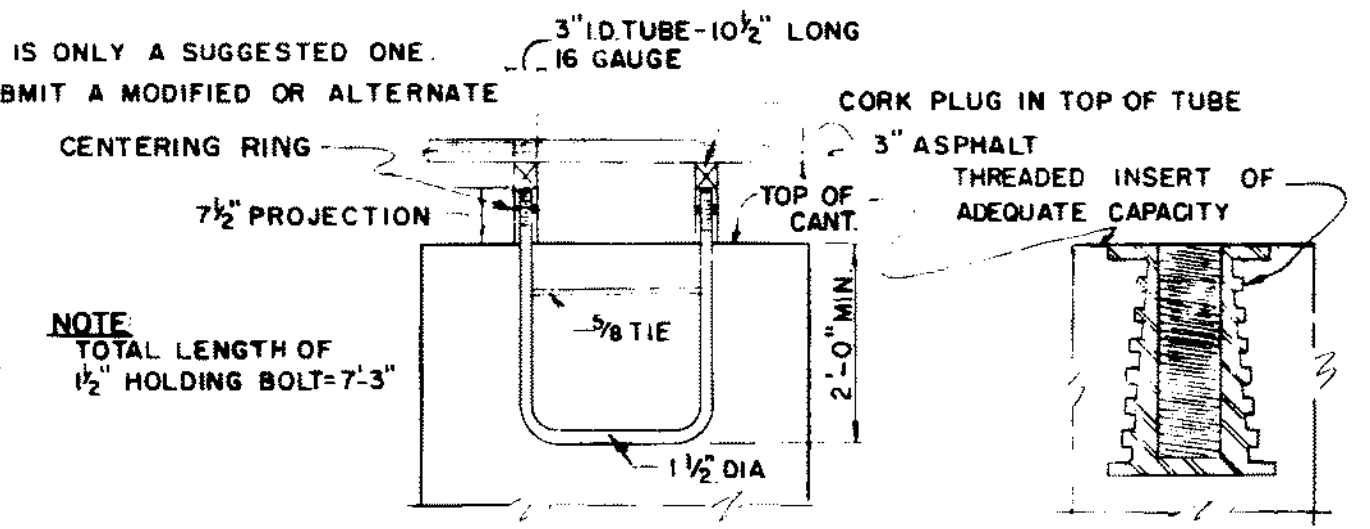

PERMANENT HOLDING BOLTS  
NOT TO SCALE

ALTERNATE  
NOT TO SCALE




| REVISIONS |      |    |
|-----------|------|----|
| NO.       | DATE | BY |
|           |      |    |
|           |      |    |
|           |      |    |
|           |      |    |

RHODE ISLAND  
 DEPARTMENT OF PUBLIC WORKS  
 DIVISION OF ROADS AND BRIDGES  
 WASHINGTON BRIDGE (NORTH)  
 CROSSING SEEKONK RIVER  
 PROVIDENCE - EAST PROVIDENCE, RHODE ISLAND






CANTILEVER BEAM ANCHORAGE

CHARLES A. MAGUIRE & ASSOCIATES  
 ENGINEERS  
 PROVIDENCE, R. I.  
 DATE JAN 1967  
 SCALE 3/4" = 1'-0"  
 EXCEPT AS NOTED

APPROVED: \_\_\_\_\_ SET NO. \_\_\_\_\_  
 SUPERVISING CIVIL ENGINEER (BRIDGE) PRINTED  
 APPROVED: \_\_\_\_\_  
 CHIEF ENGINEER ISSUED TO \_\_\_\_\_  
 FINAL DATE \_\_\_\_\_

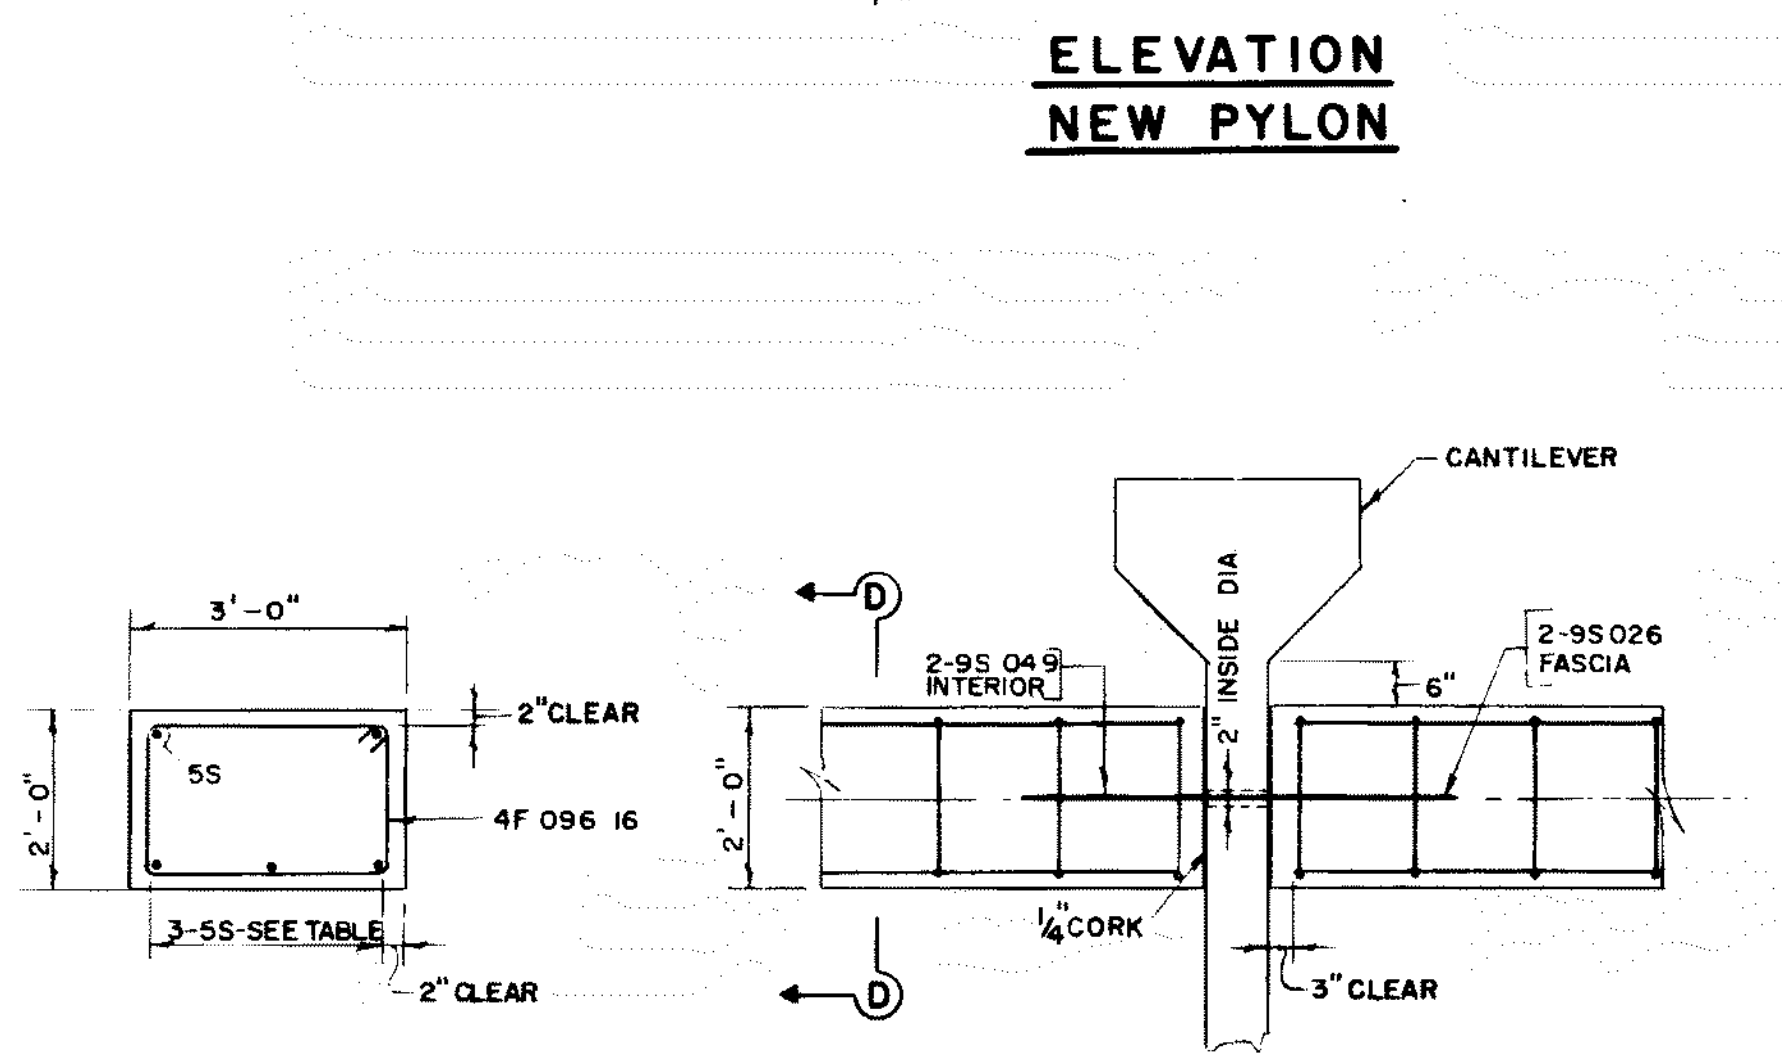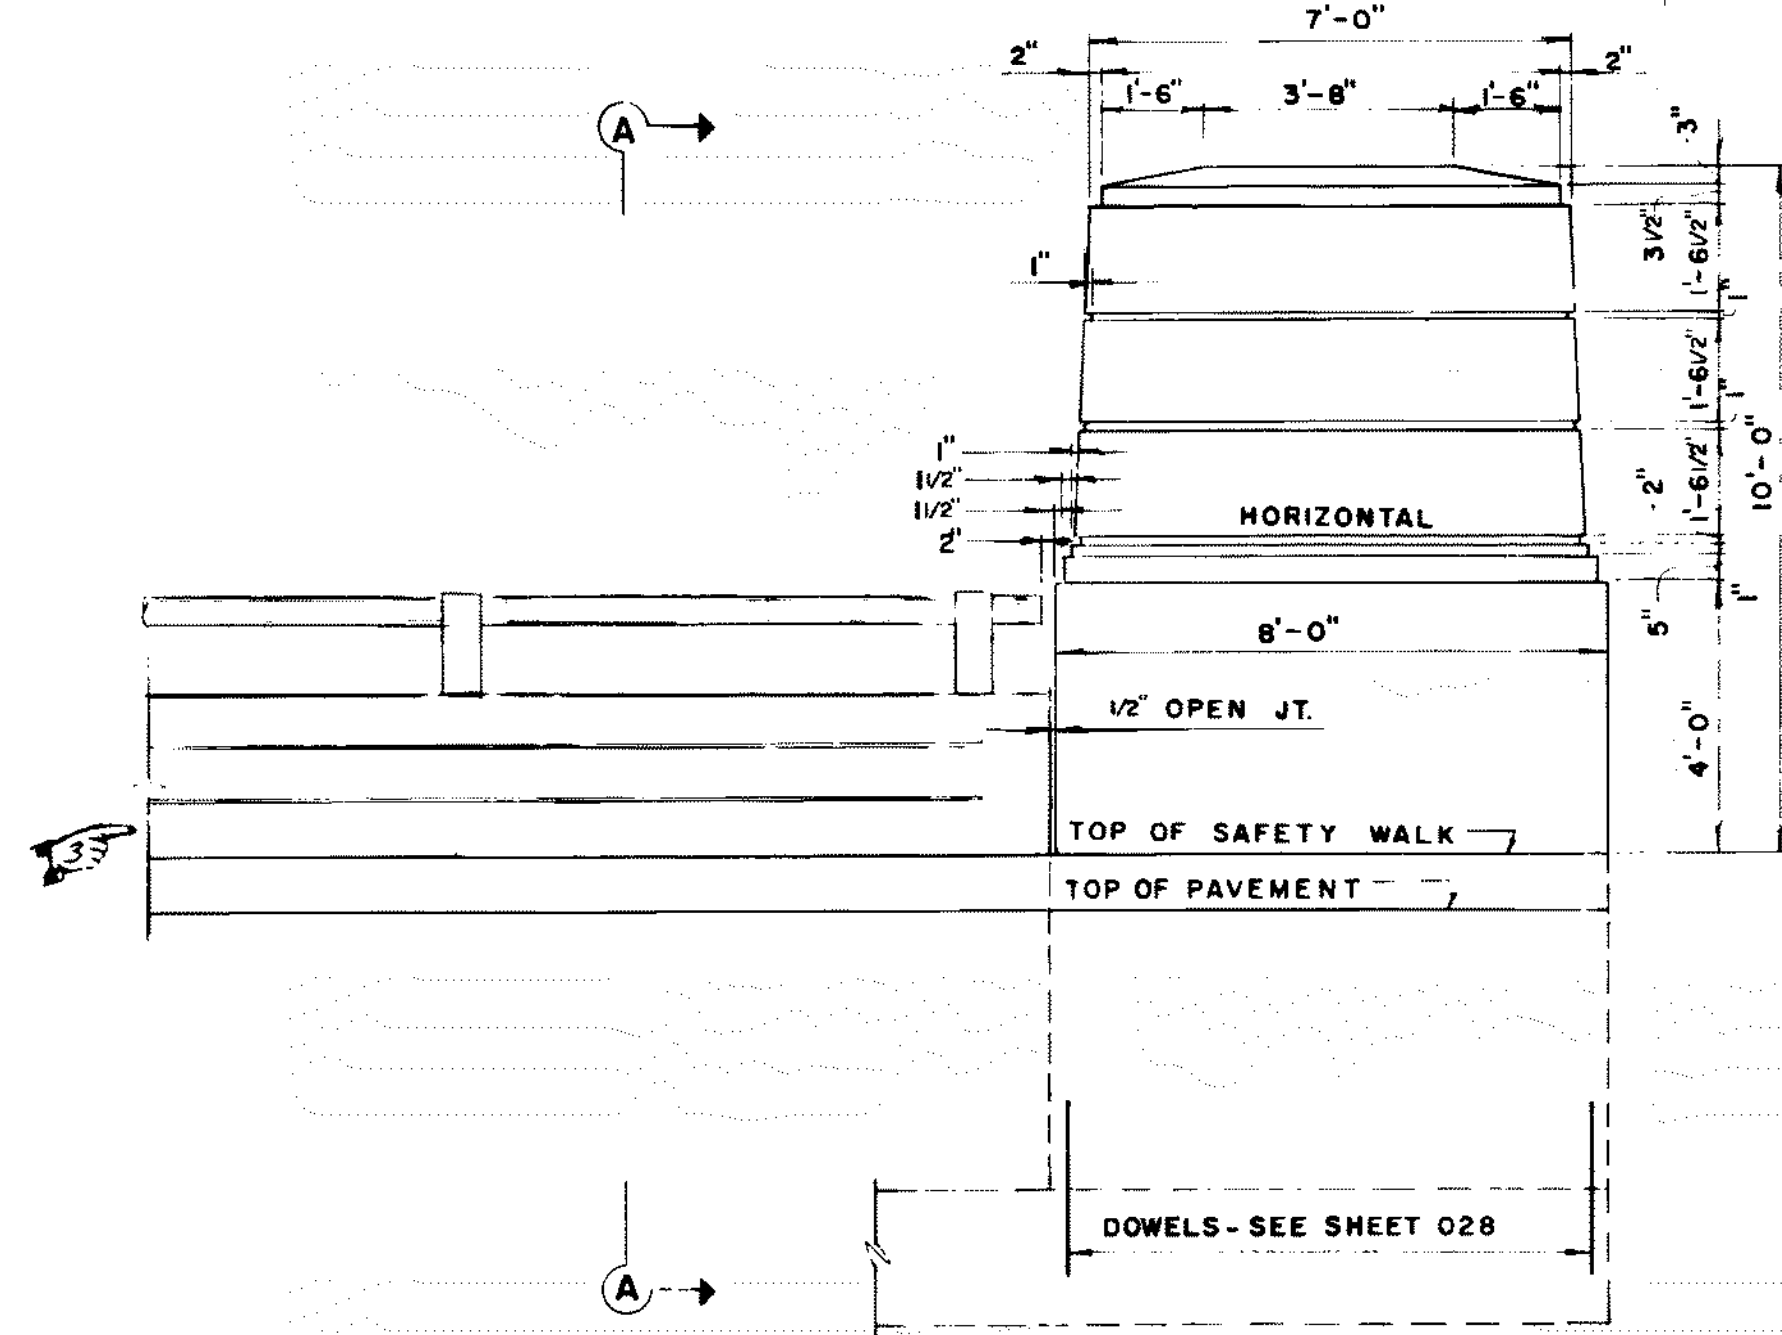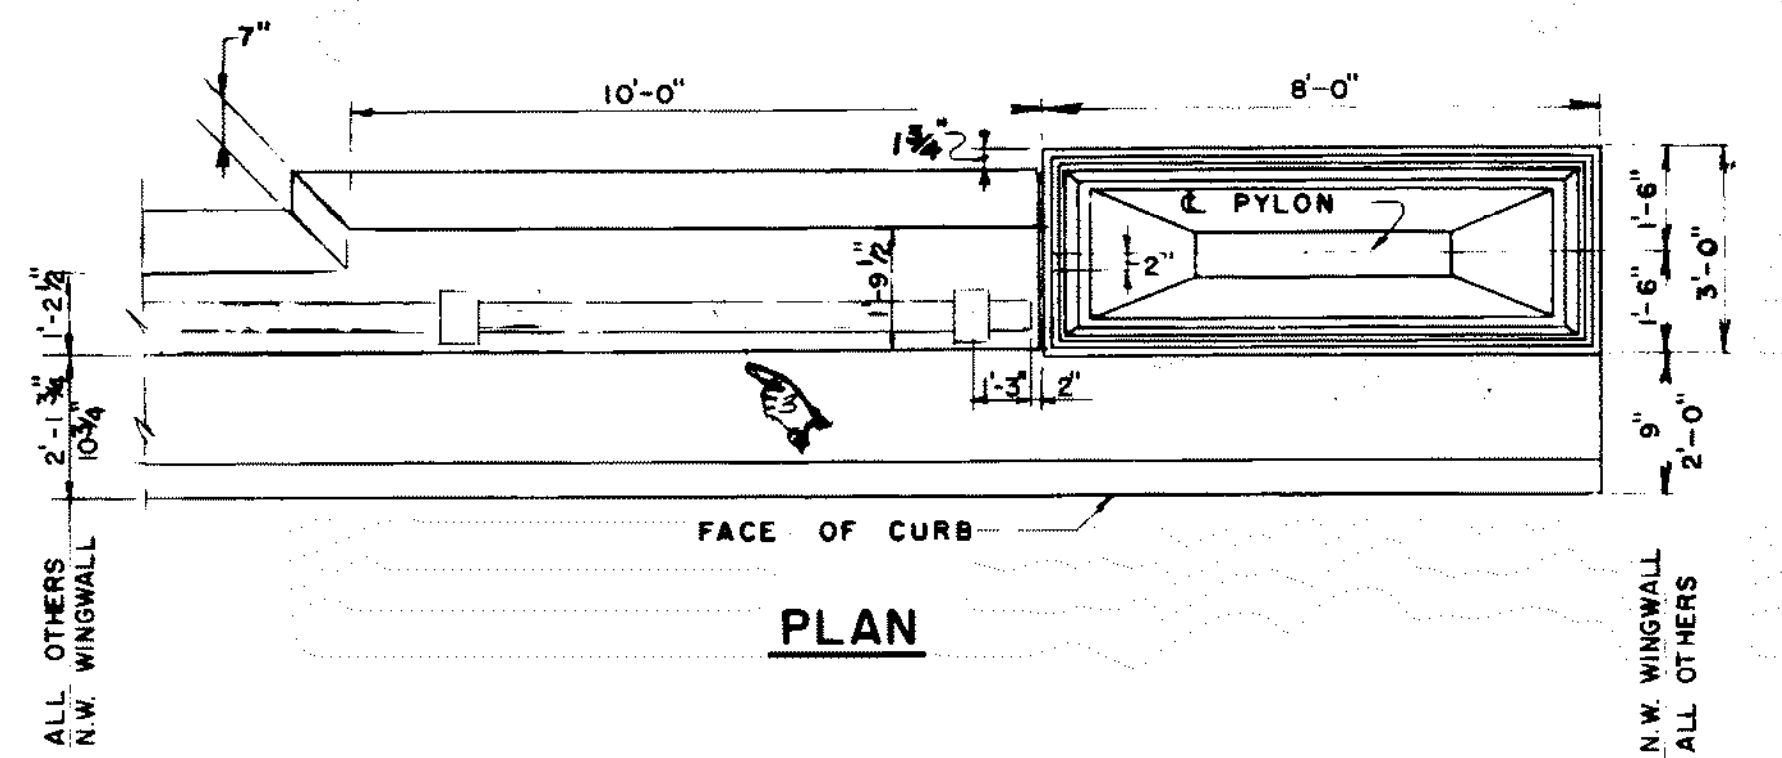

| PIER NO | NO DIAPMS | LENGTH |
|---------|-----------|--------|
| ABUT 1  | 5         | 9'-9"  |
| 1       | 5         | 10'-0" |
| 2       | 5         | 10'-6" |
| 3       | 5         | 10'-9" |
| 4       | 5         | 11'-0" |
| 5       | 4         | 11'-0" |
| 5       | 2         | 6'-3"  |
| 6-13    | 5         | 11'-0" |

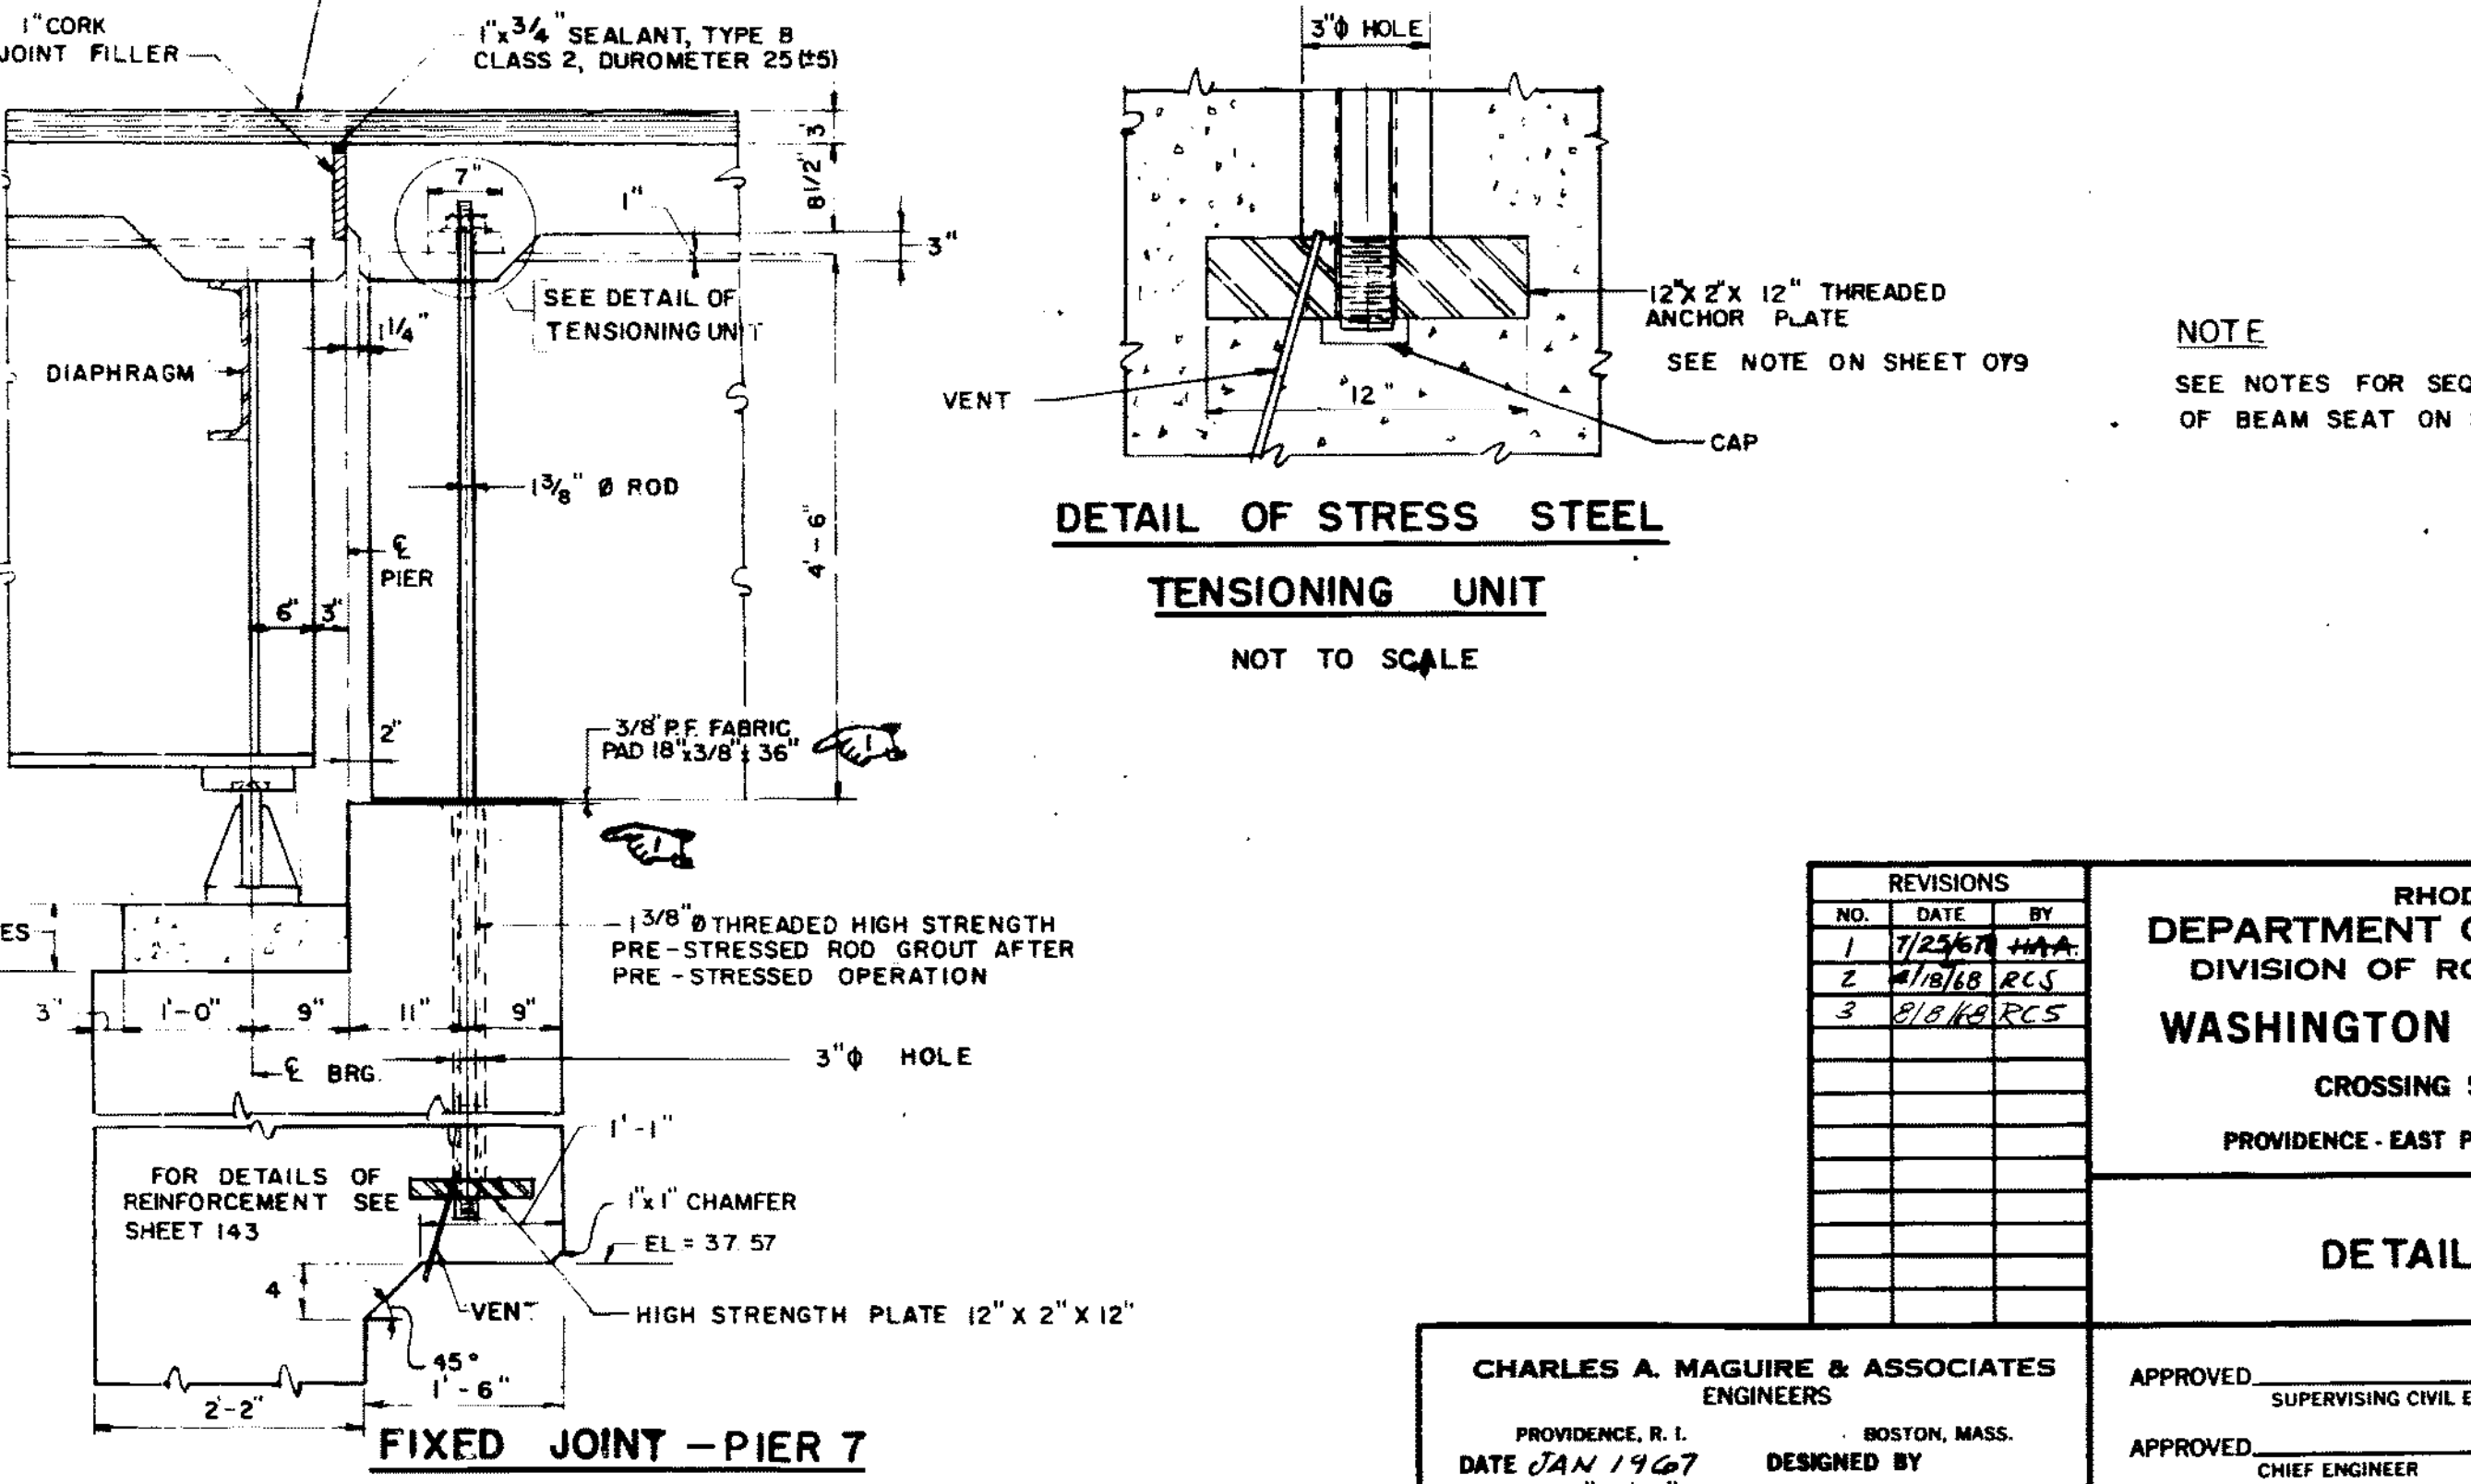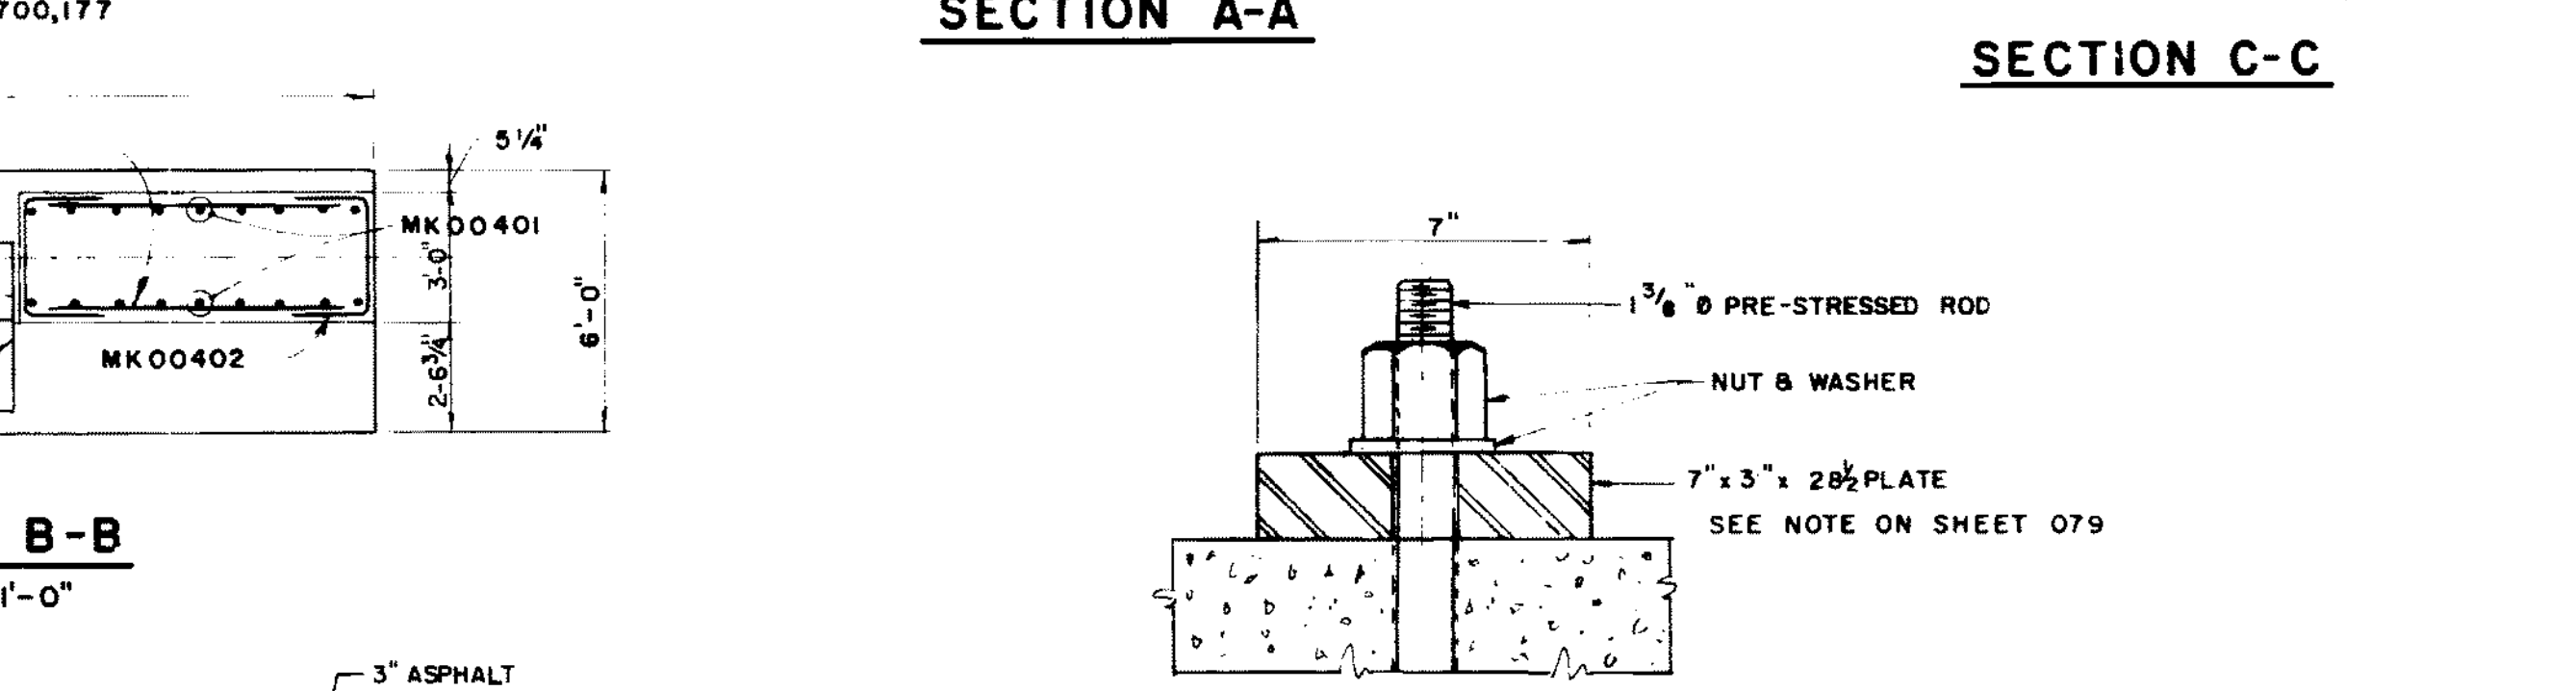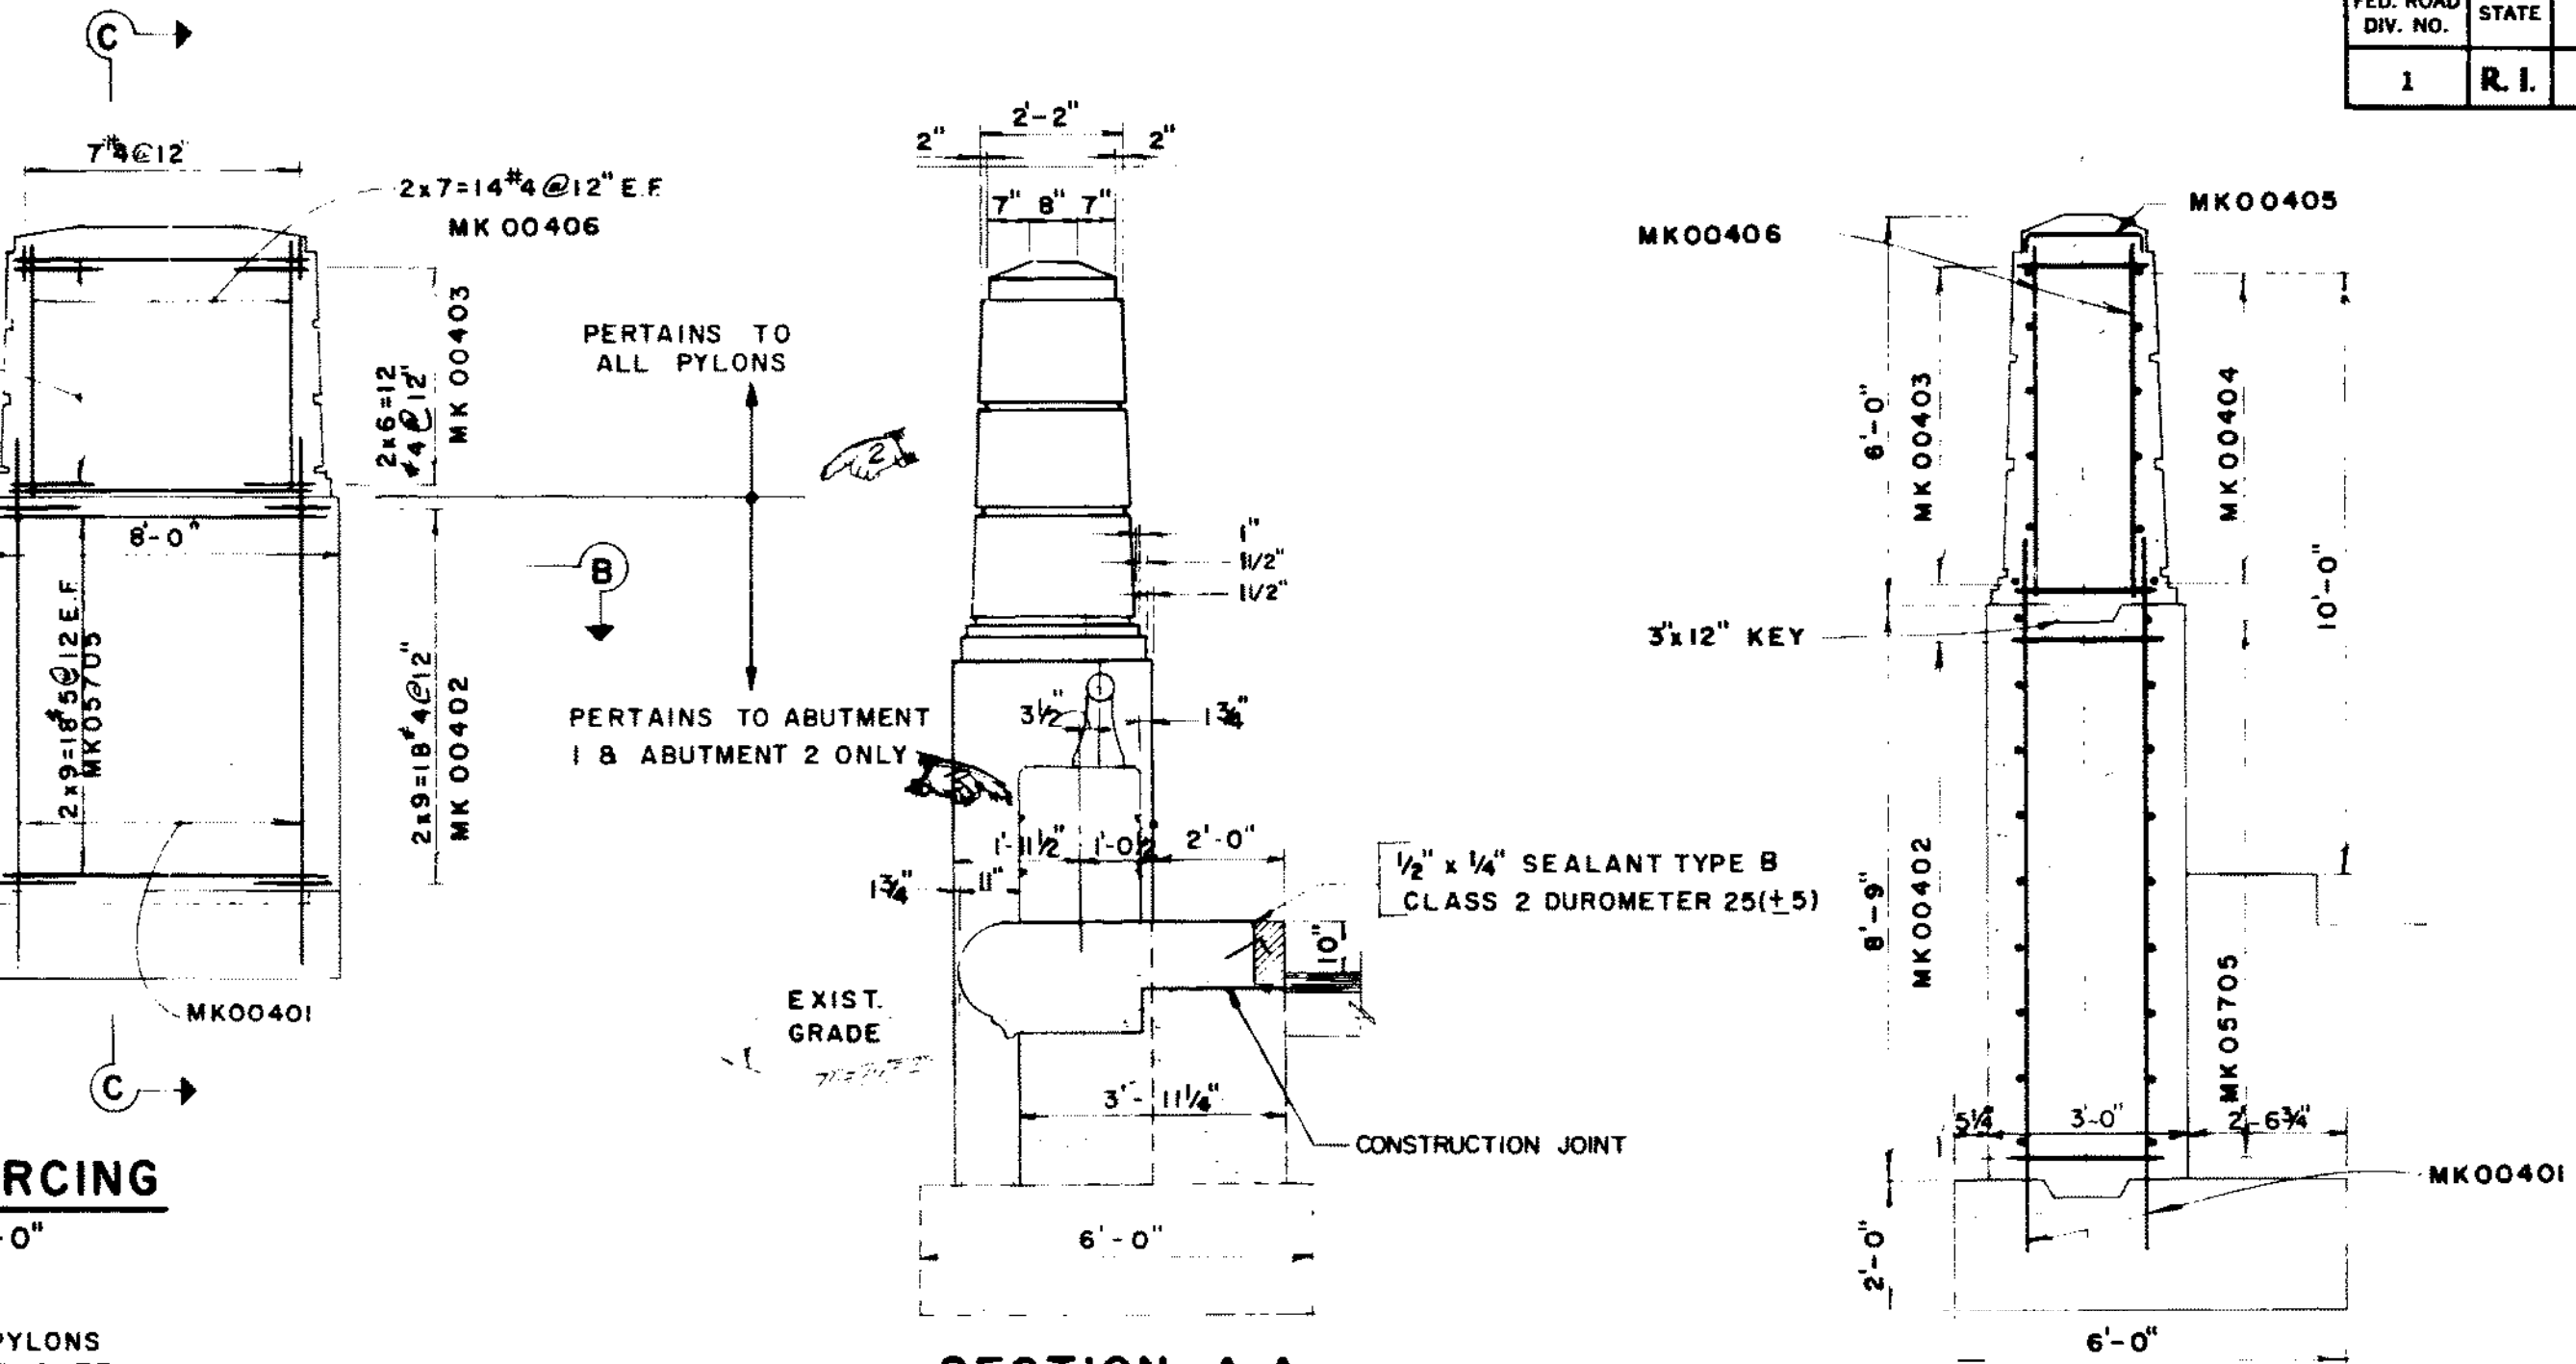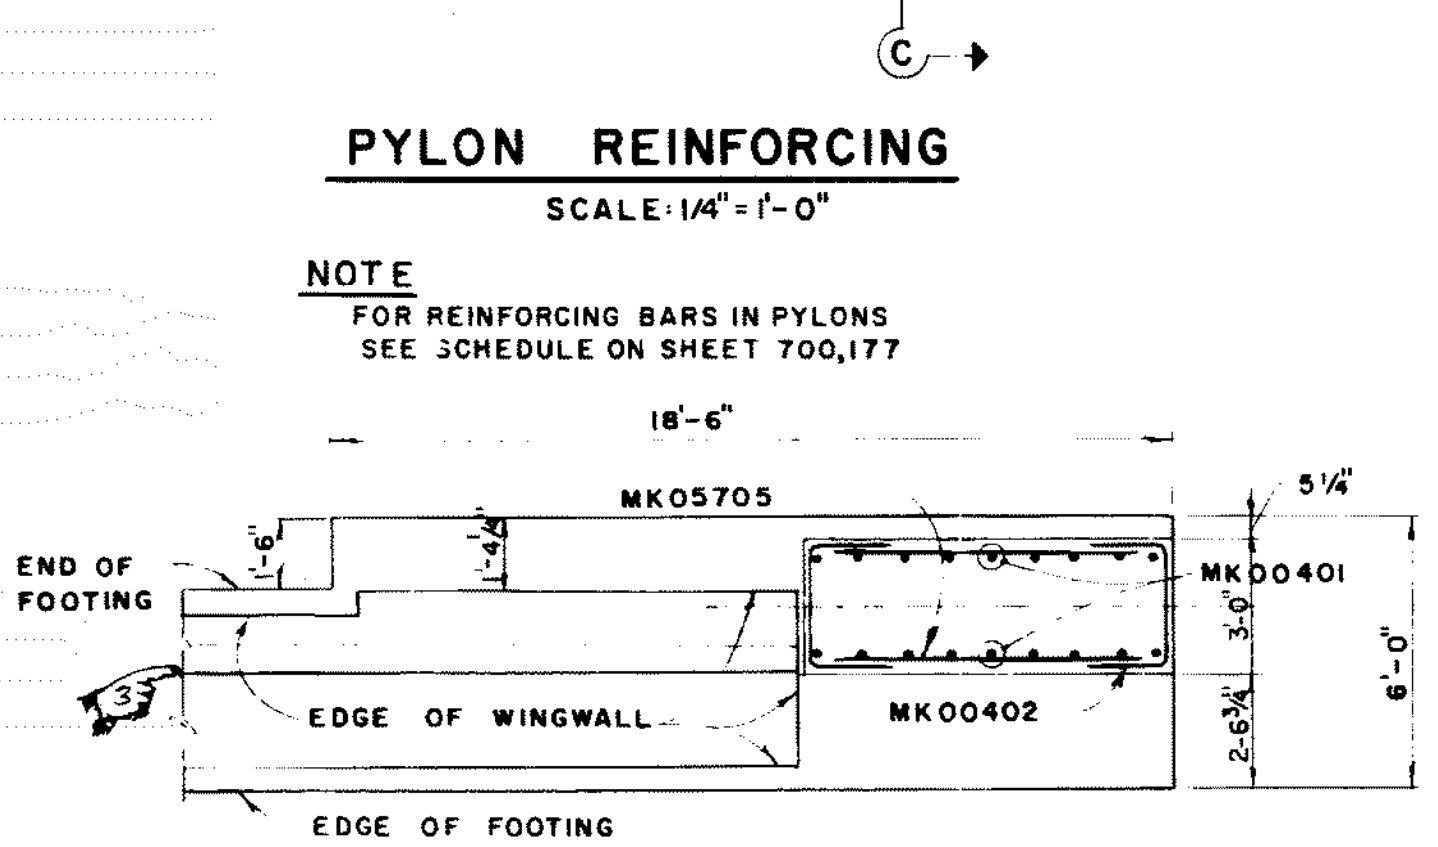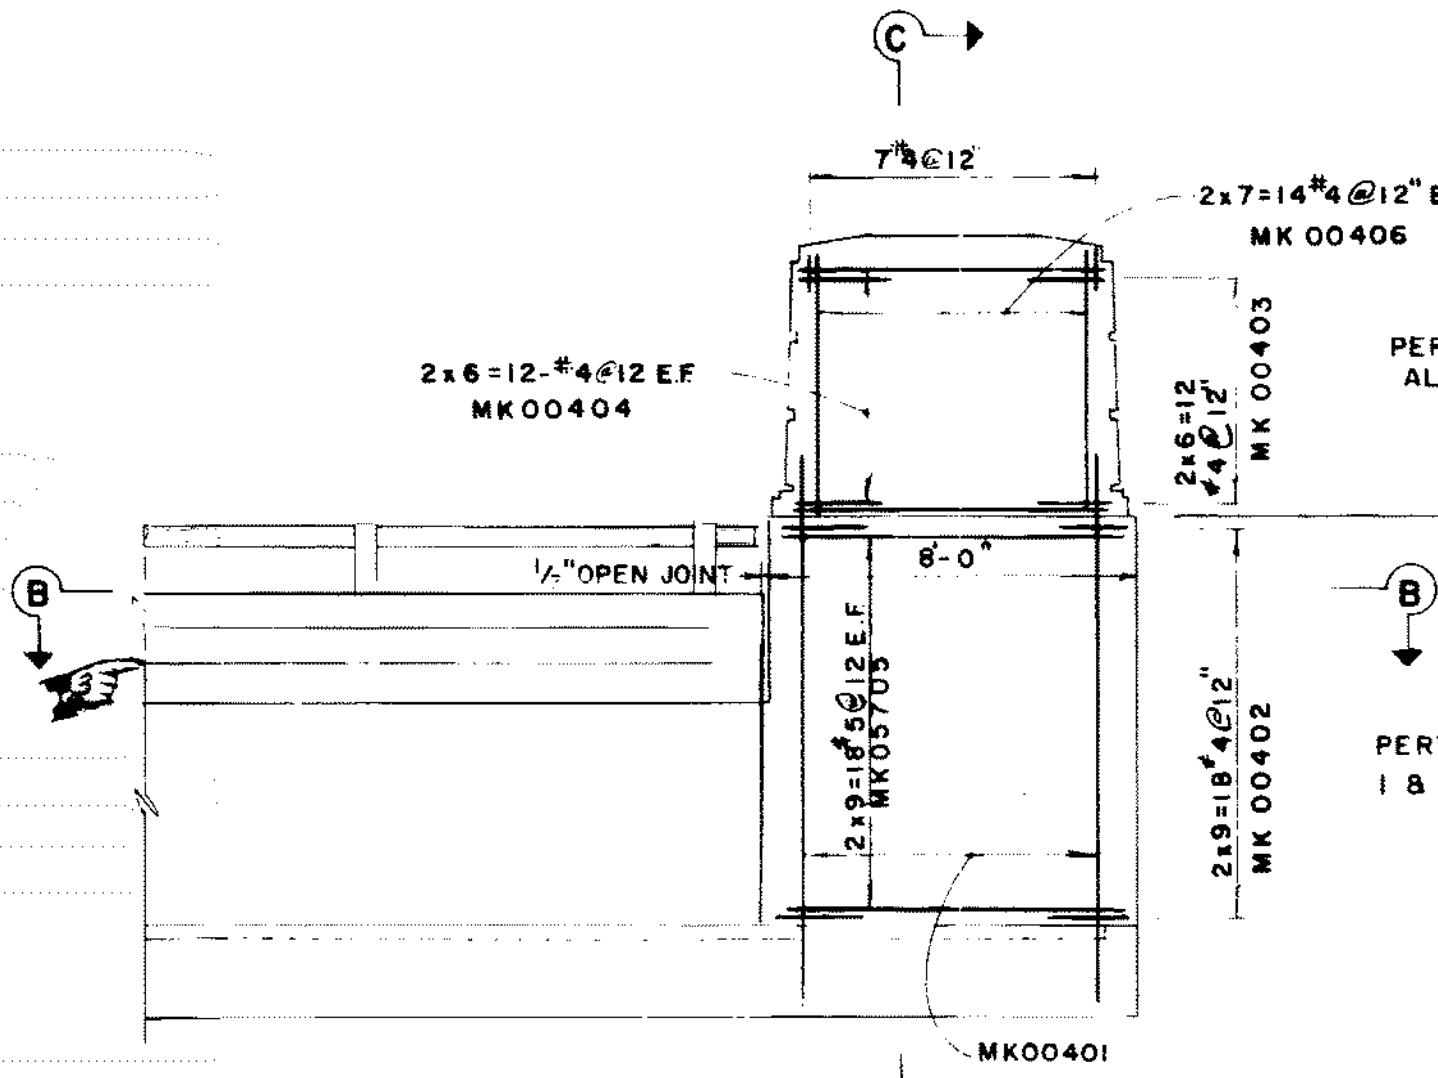

**NOTE**  
SEE NOTES FOR SEQUENCE OF CONSTRUCTION OF BEAM SEAT ON SHEET 143

| NO. | DATE    | BY  |
|-----|---------|-----|
| 1   | 7/23/67 | HAA |
| 2   | 1/18/68 | RCS |
| 3   | 8/24/68 | RCS |





RHODE ISLAND  
DEPARTMENT OF PUBLIC WORKS  
DIVISION OF ROADS AND BRIDGES  
**WASHINGTON BRIDGE (NORTH)**  
CROSSING SEEKONK RIVER  
PROVIDENCE - EAST PROVIDENCE, RHODE ISLAND

**DETAIL SHEET 4**

**CHARLES A. MAGUIRE & ASSOCIATES**  
ENGINEERS  
PROVIDENCE, R. I.  
DATE JAN 1967  
SCALE 3/8" = 1'-0"  
EXCEPT AS NOTED

APPROVED: \_\_\_\_\_  
SUPERVISING CIVIL ENGINEER (BRIDGE)  
APPROVED: \_\_\_\_\_  
CHIEF ENGINEER  
FINAL DATE: \_\_\_\_\_  
SET NO. \_\_\_\_\_  
PRINTED \_\_\_\_\_  
ISSUED TO \_\_\_\_\_



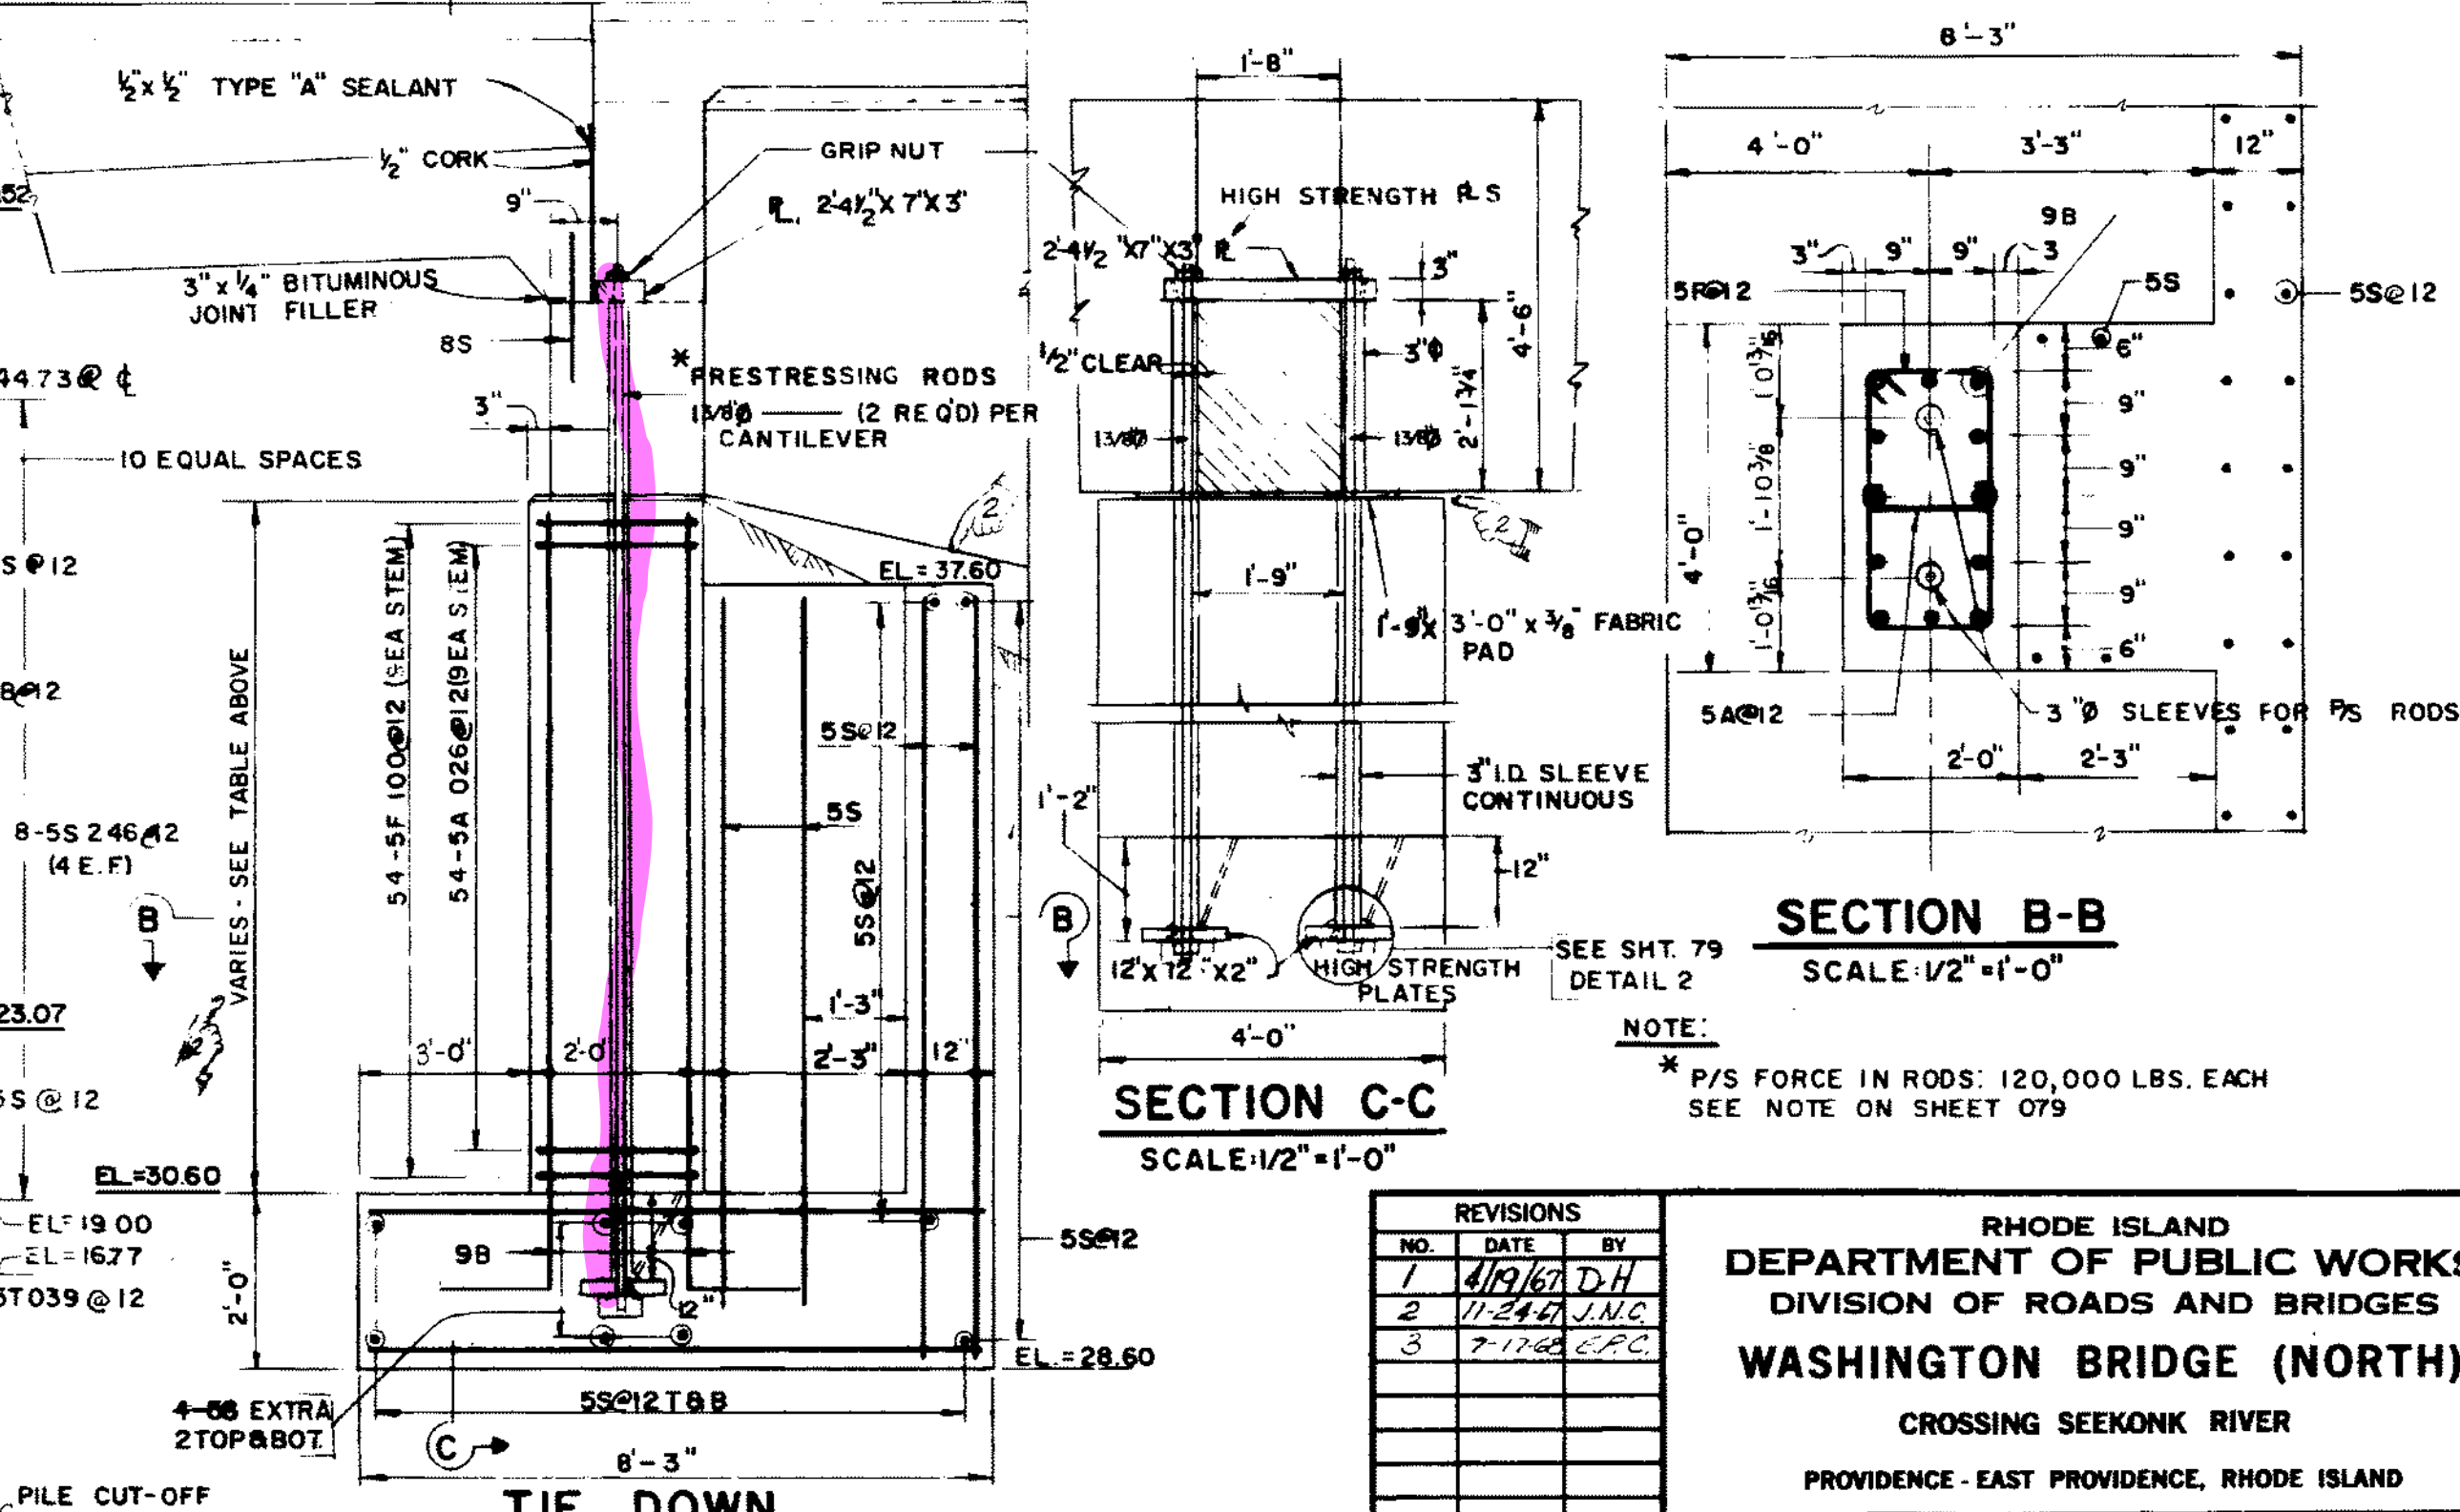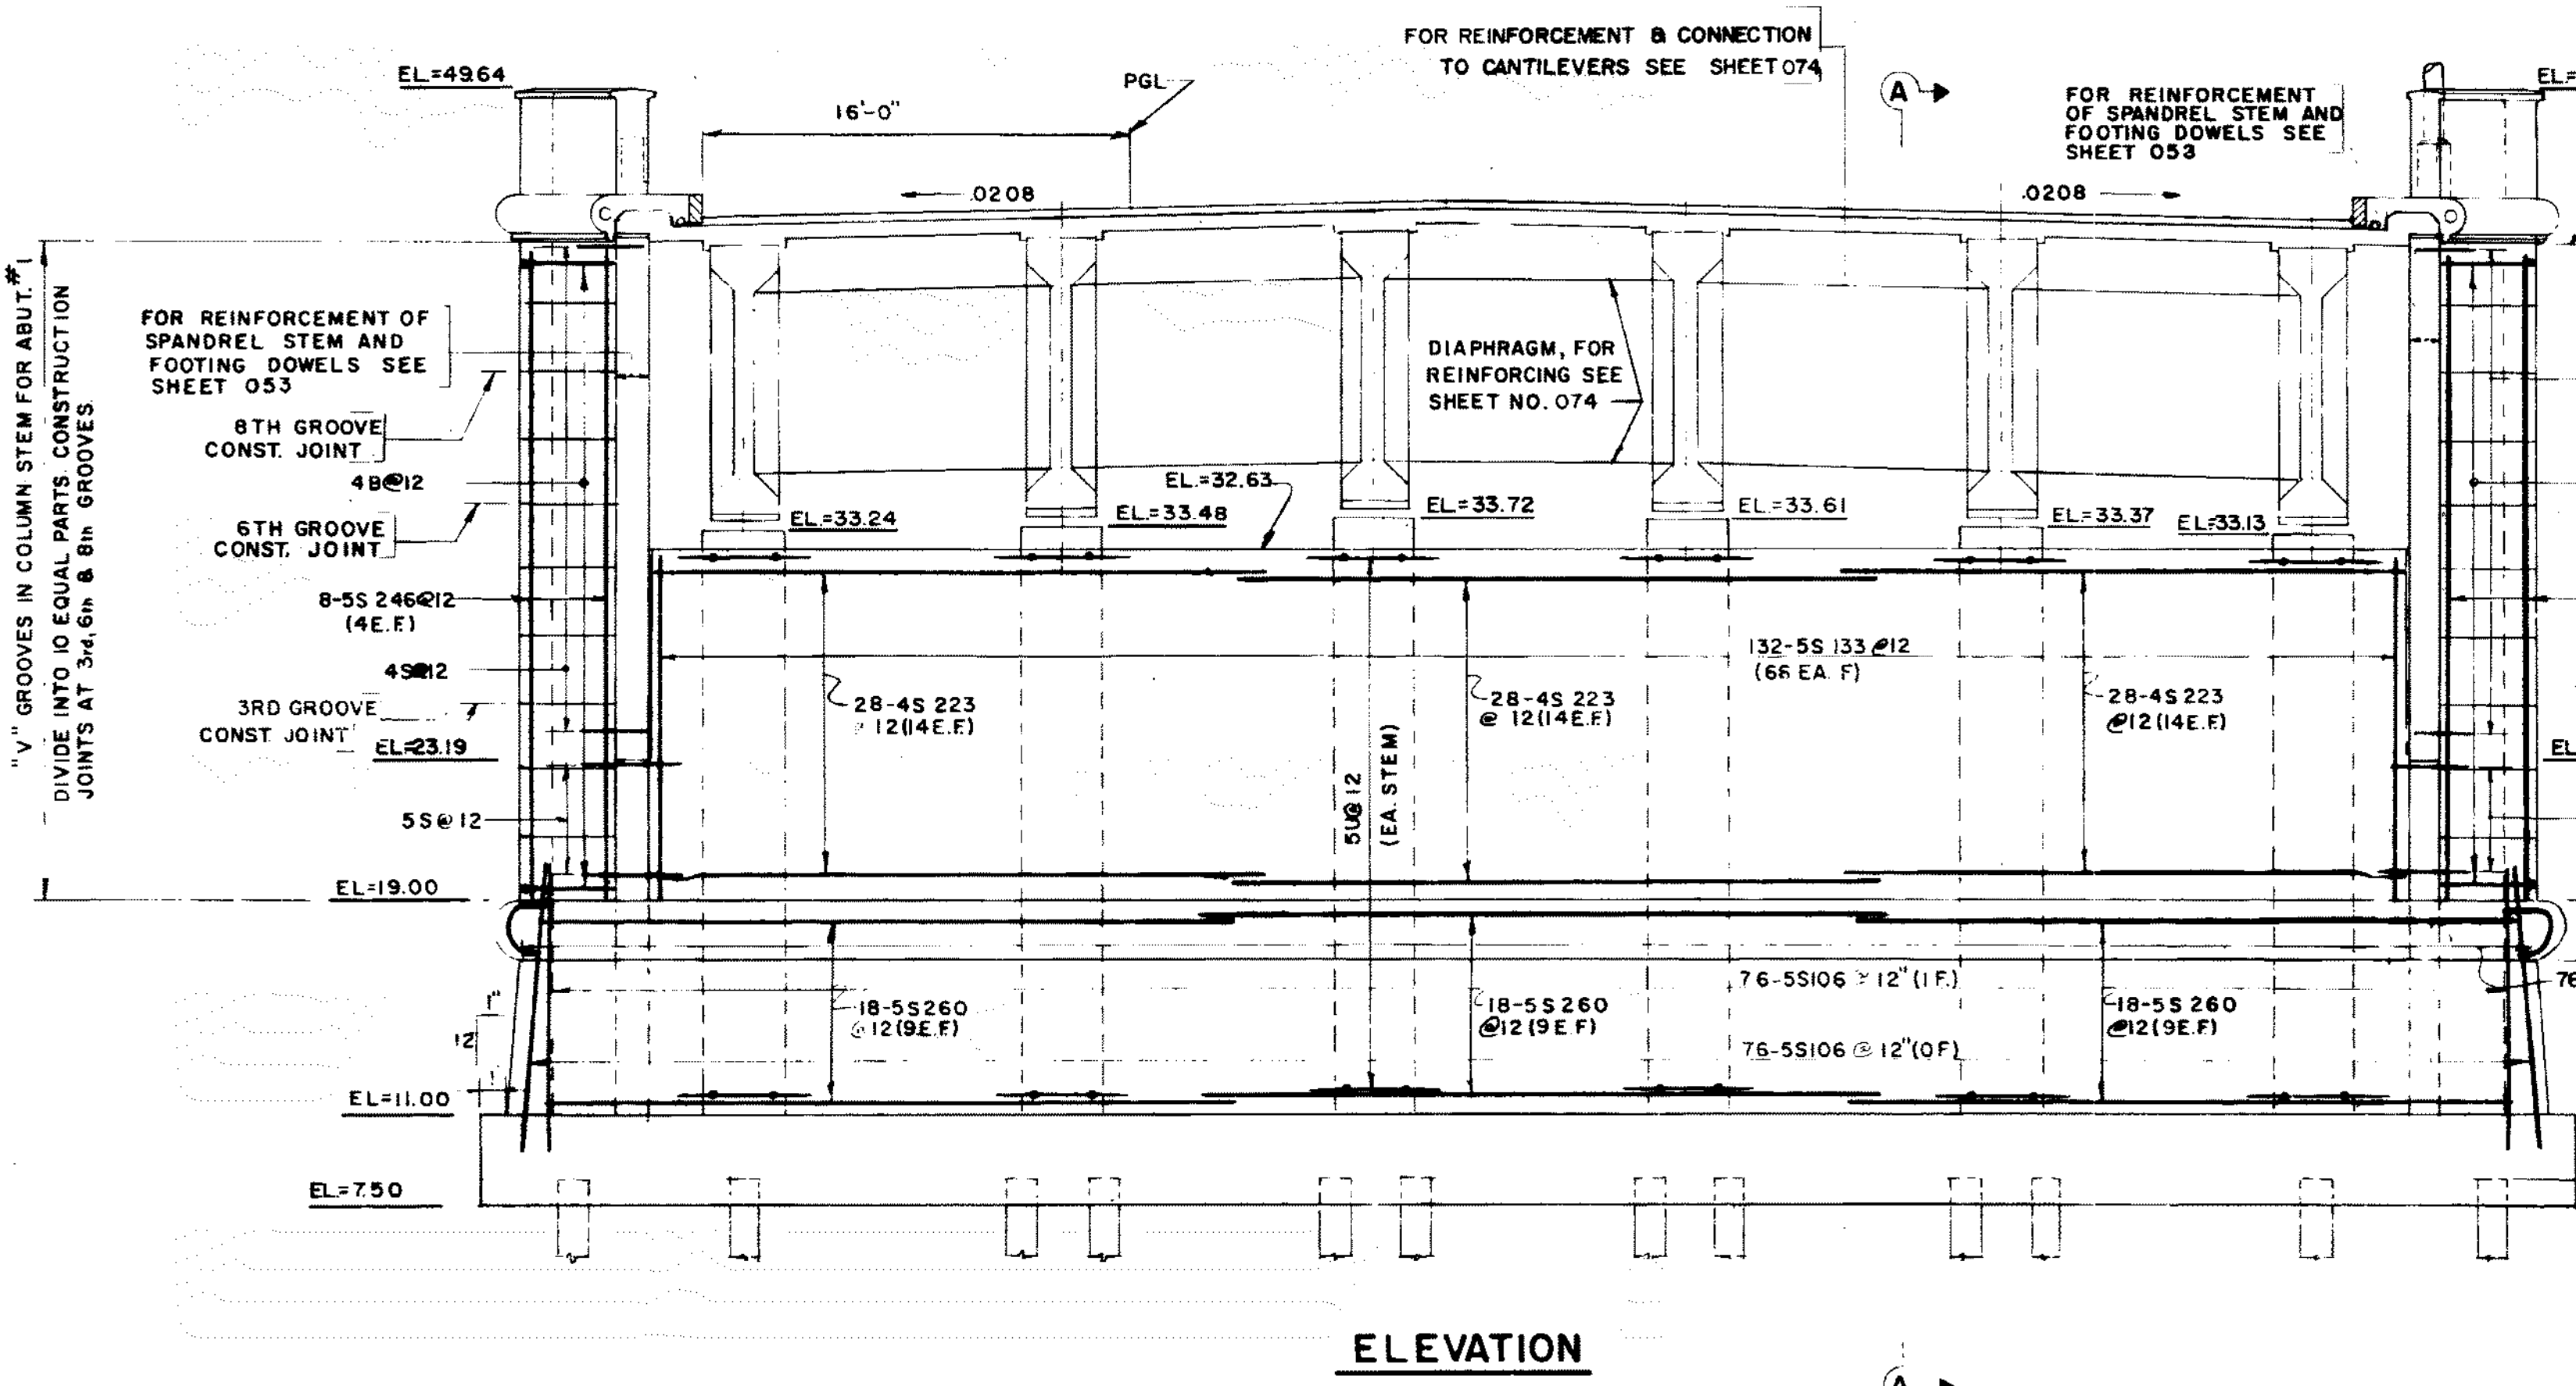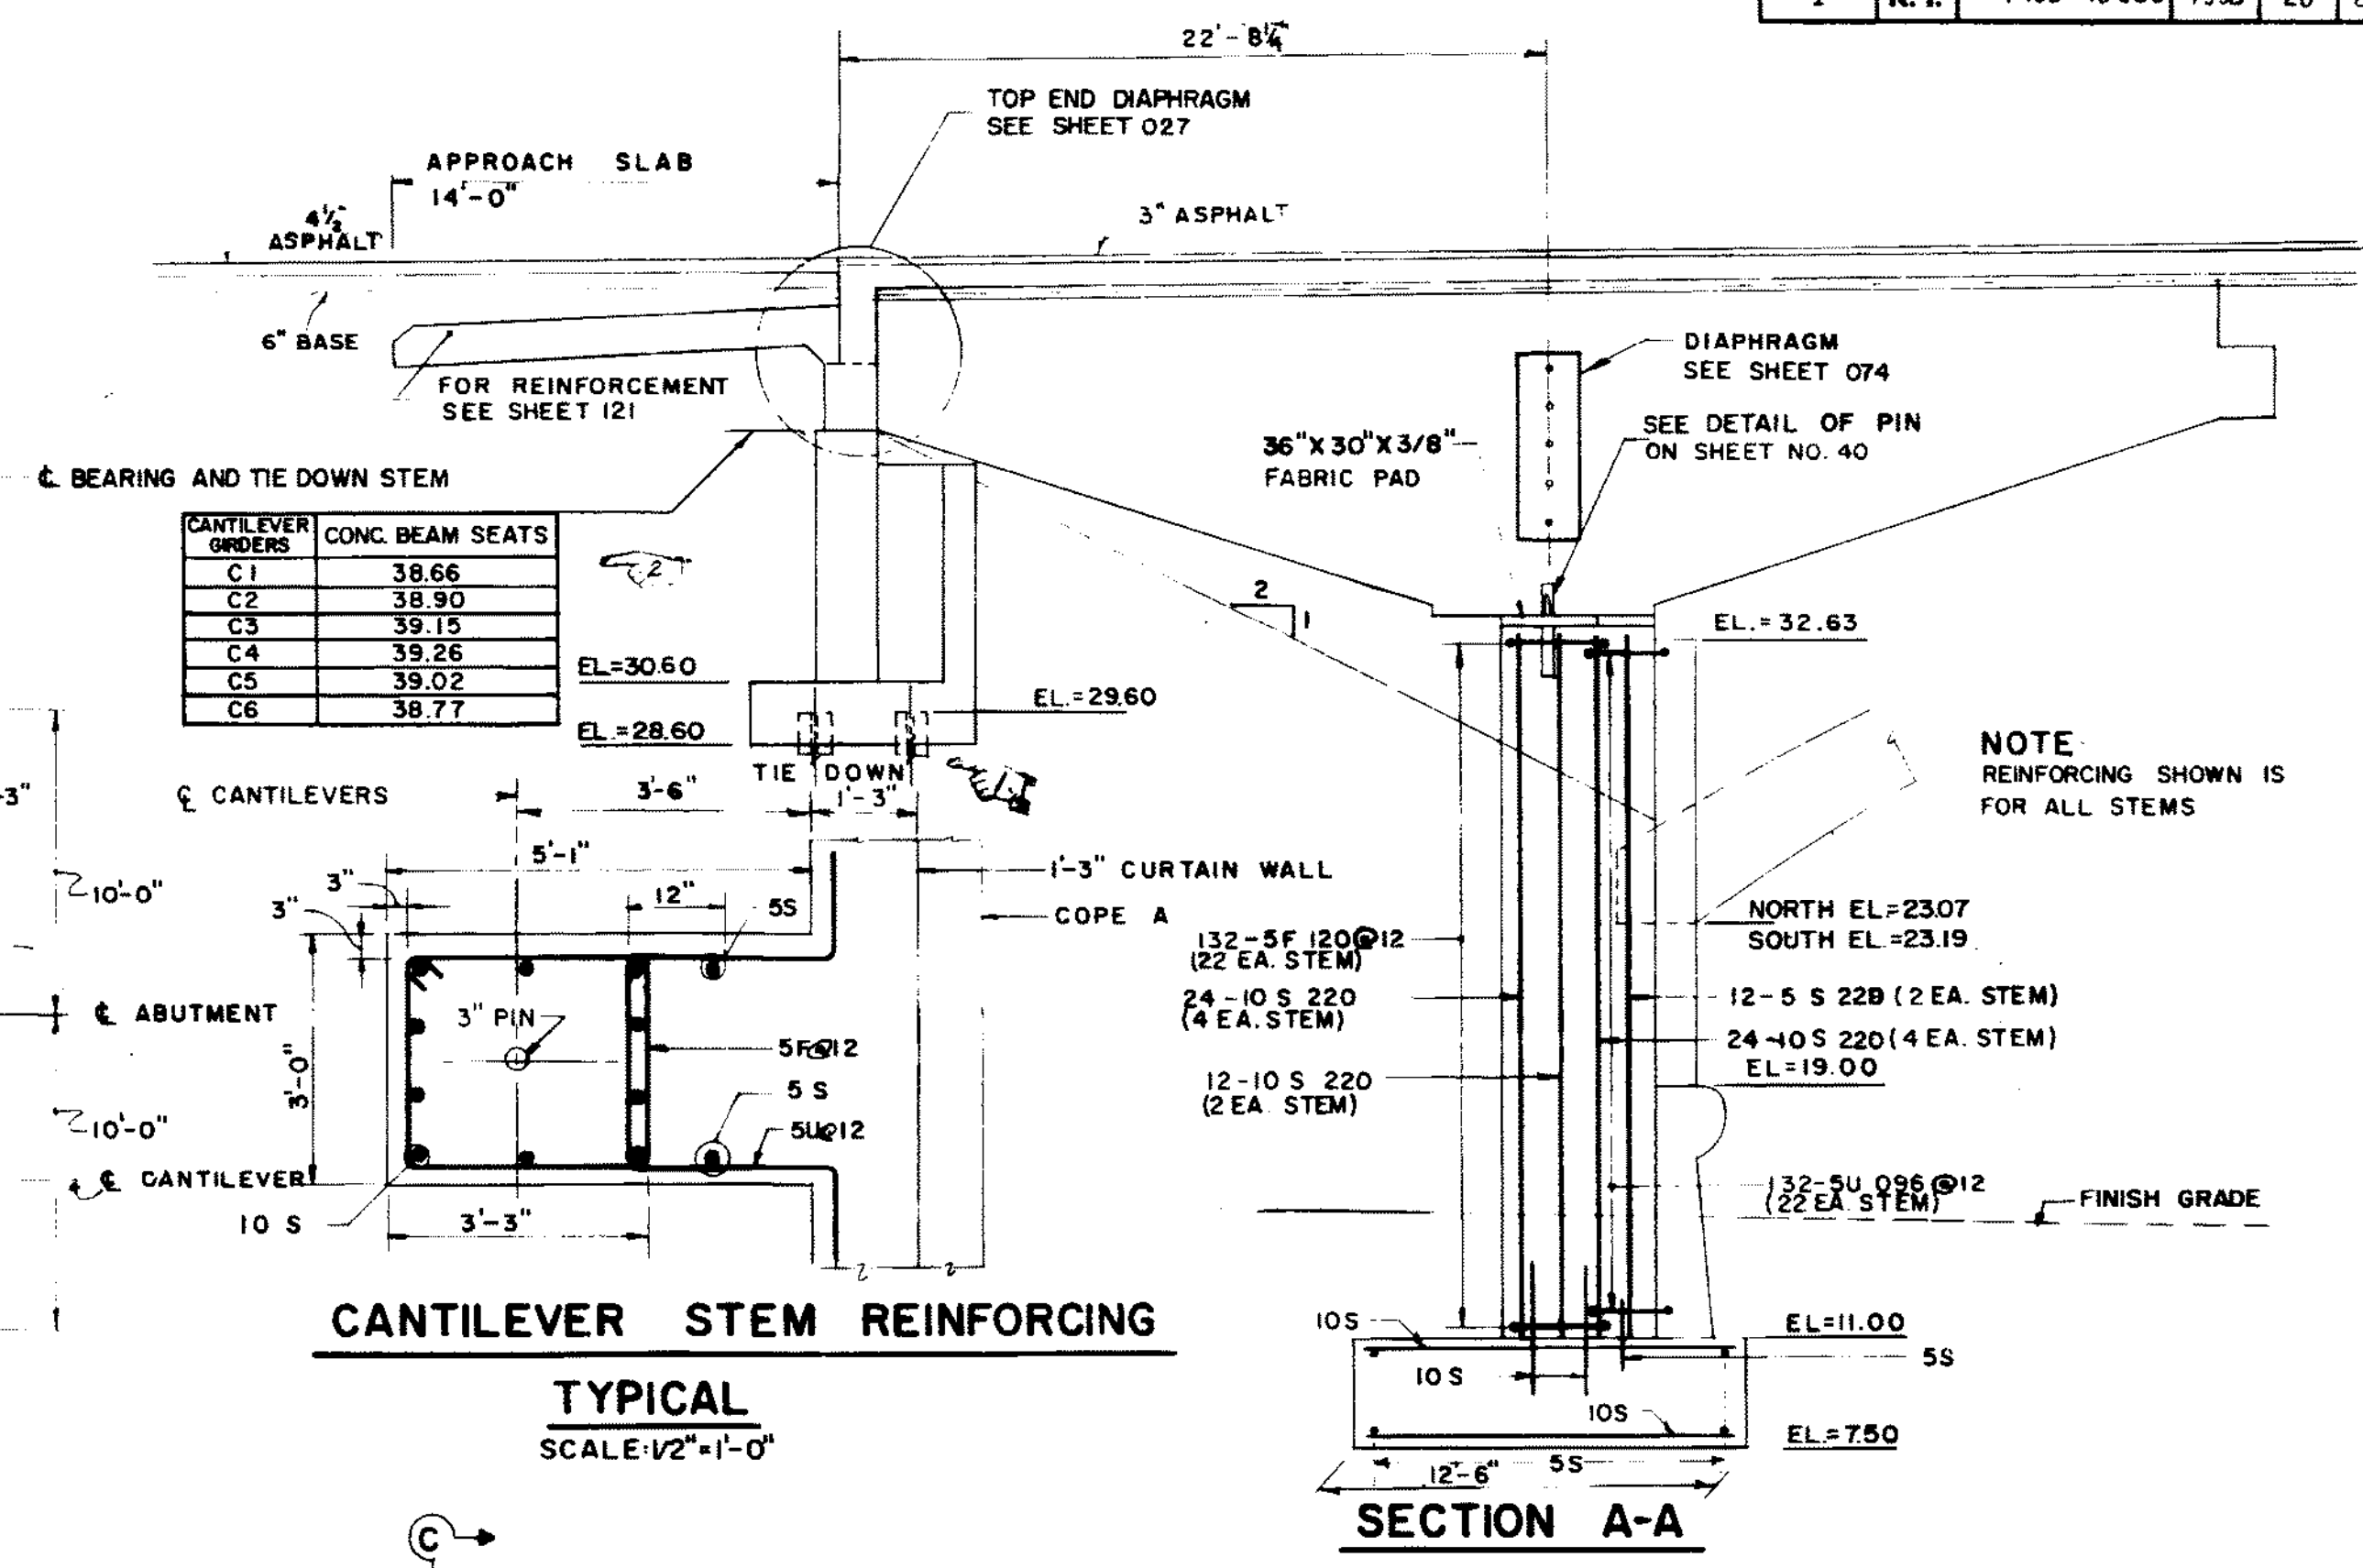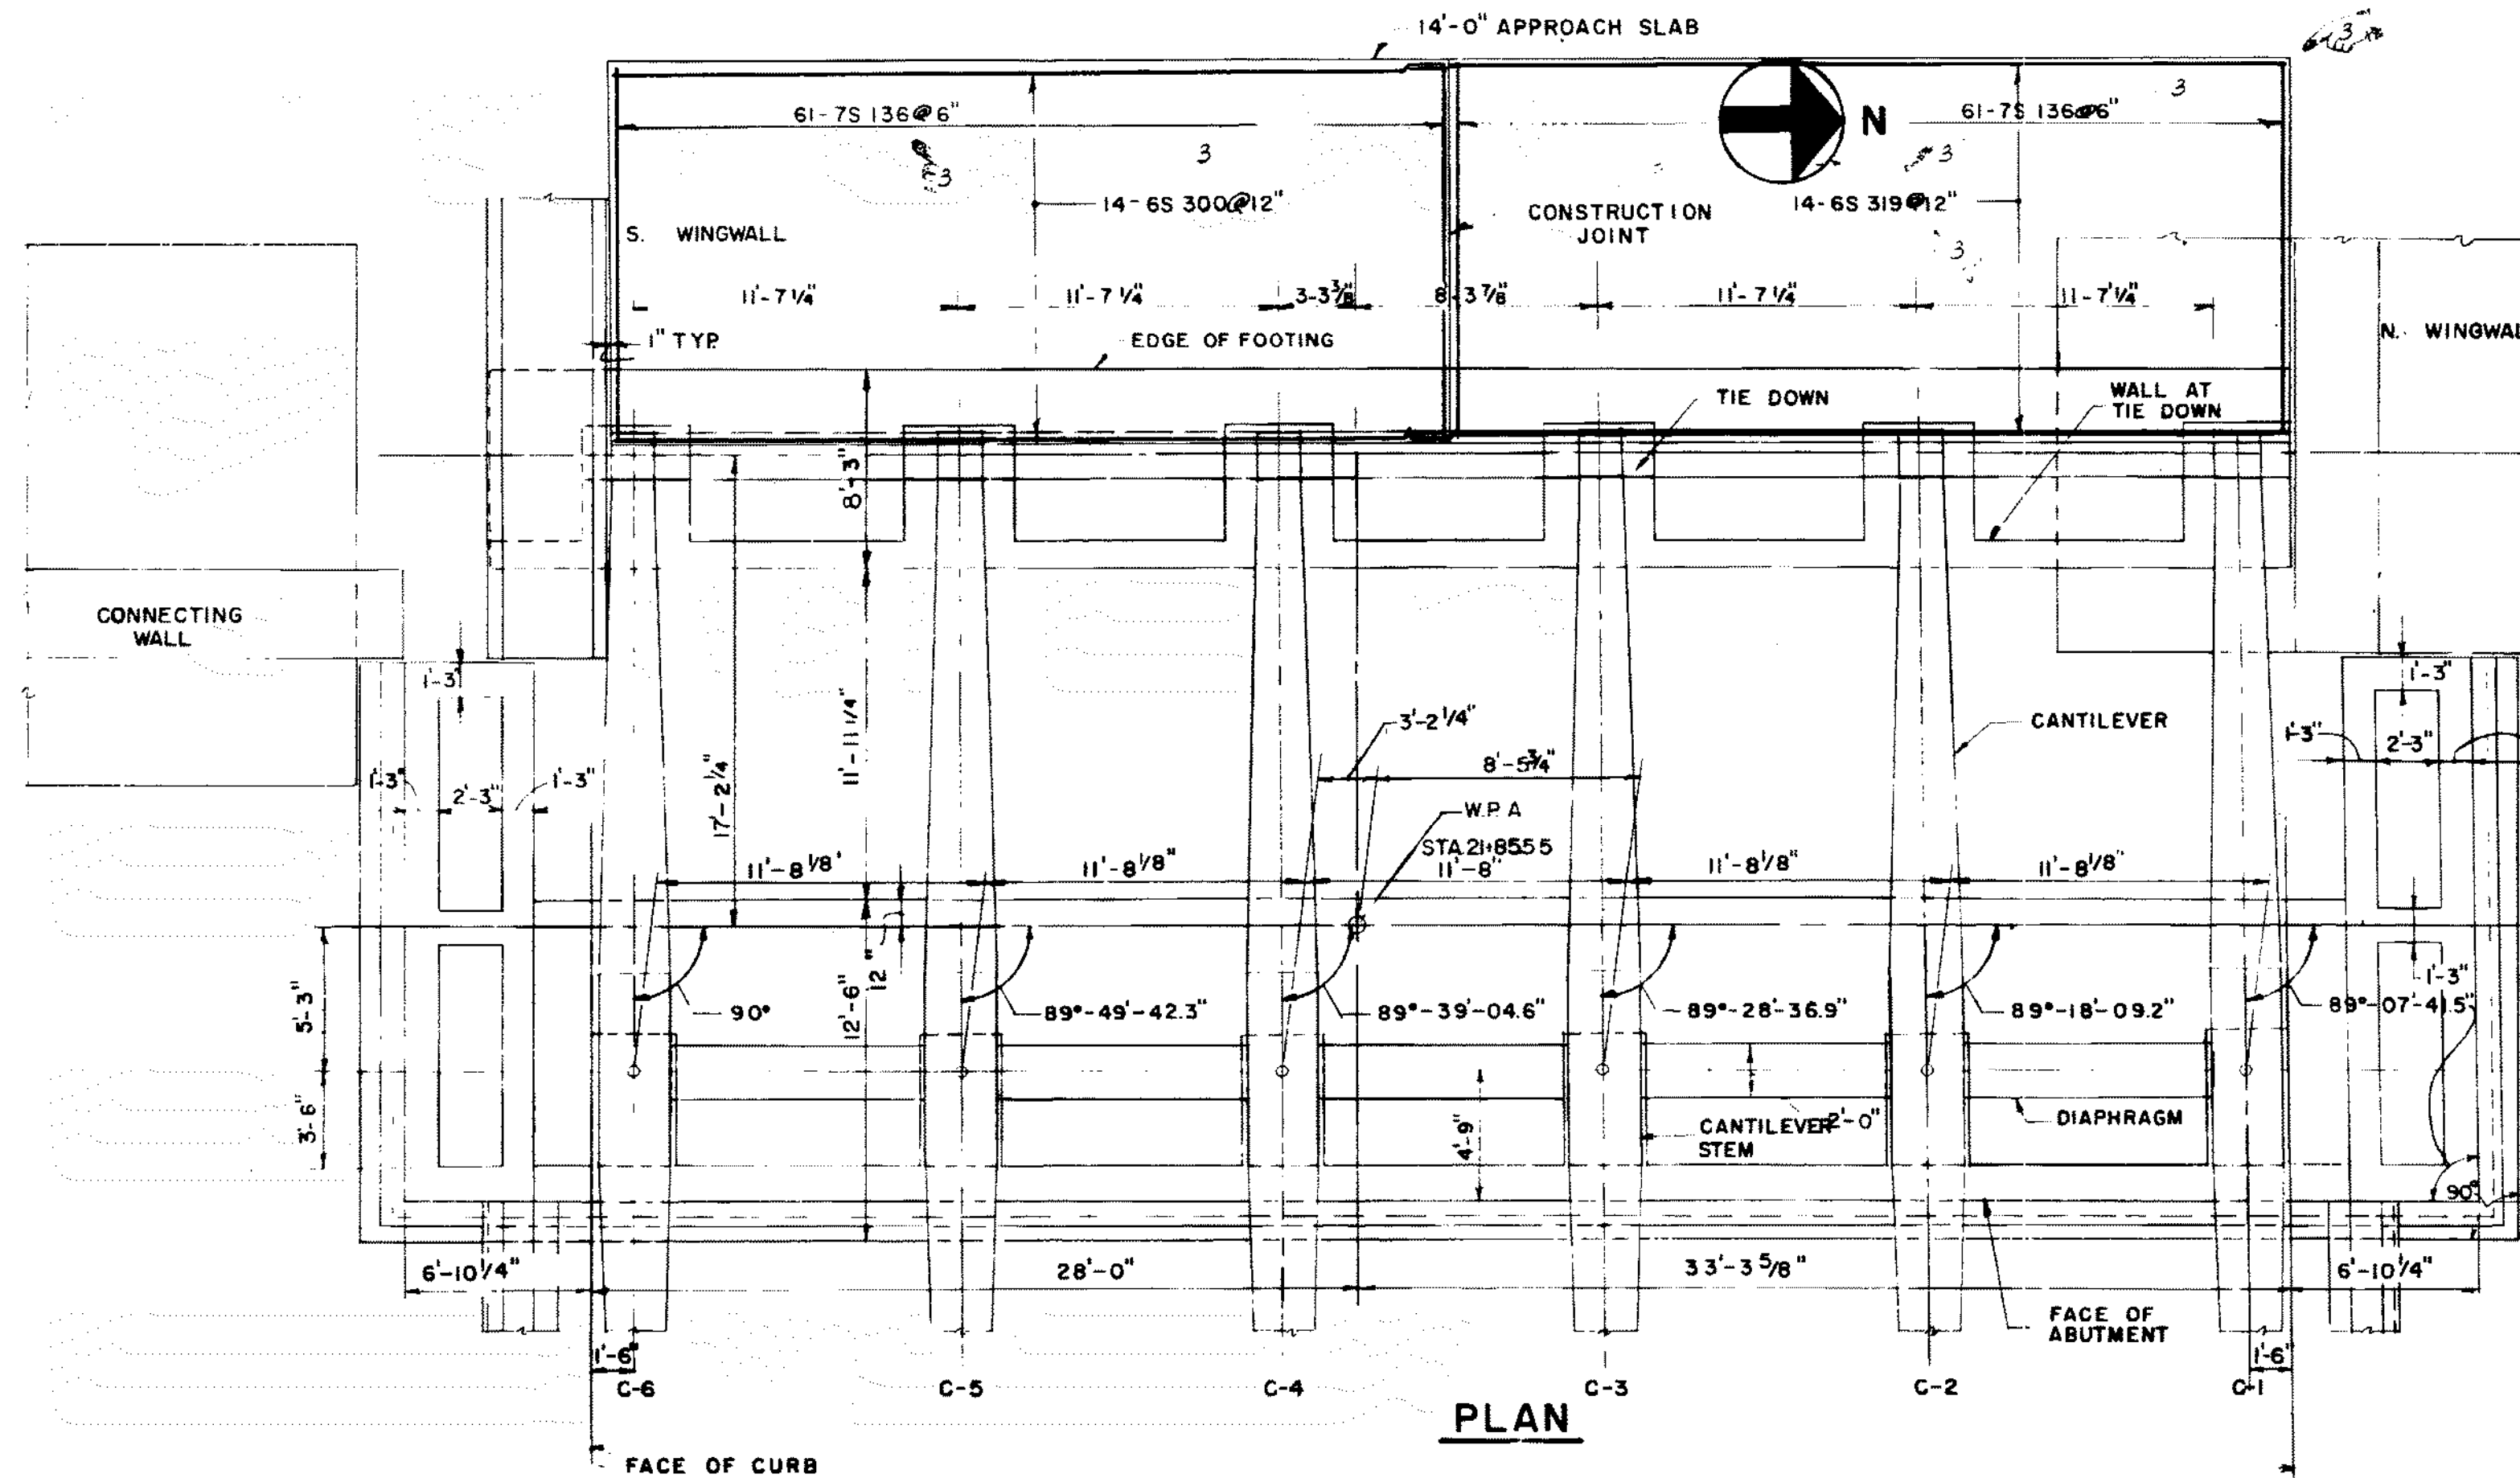

| NO. | DATE     | BY     |
|-----|----------|--------|
| 1   | 8/19/67  | D.H.   |
| 2   | 11/24/67 | J.N.C. |
| 3   | 7/1/68   | E.P.C. |

RHODE ISLAND DEPARTMENT OF PUBLIC WORKS  
DIVISION OF ROADS AND BRIDGES  
**WASHINGTON BRIDGE (NORTH)**  
CROSSING SEEKONK RIVER  
PROVIDENCE - EAST PROVIDENCE, RHODE ISLAND

**ABUTMENT I  
SHEET - I**




CHARLES A. MAGUIRE & ASSOCIATES ENGINEERS  
PROVIDENCE, R. I. BOSTON, MASS.  
DATE 7/11/67 DESIGNED BY  
SCALE 3/16" = 1'-0"  
APPROVED SUPERVISING CIVIL ENGINEER (BRIDGE)  
APPROVED CHIEF ENGINEER  
FINAL DATE  
SET NO. PRINTED  
ISSUED TO







| FED. ROAD DIV. NO. | STATE | FED. AID PROJ. NO. | FISCAL YEAR | SHEET NO. | TOTAL SHEETS |
|--------------------|-------|--------------------|-------------|-----------|--------------|
| 1                  | R. I. | 1-195-4(438)       | 1968        | 70        | 223          |

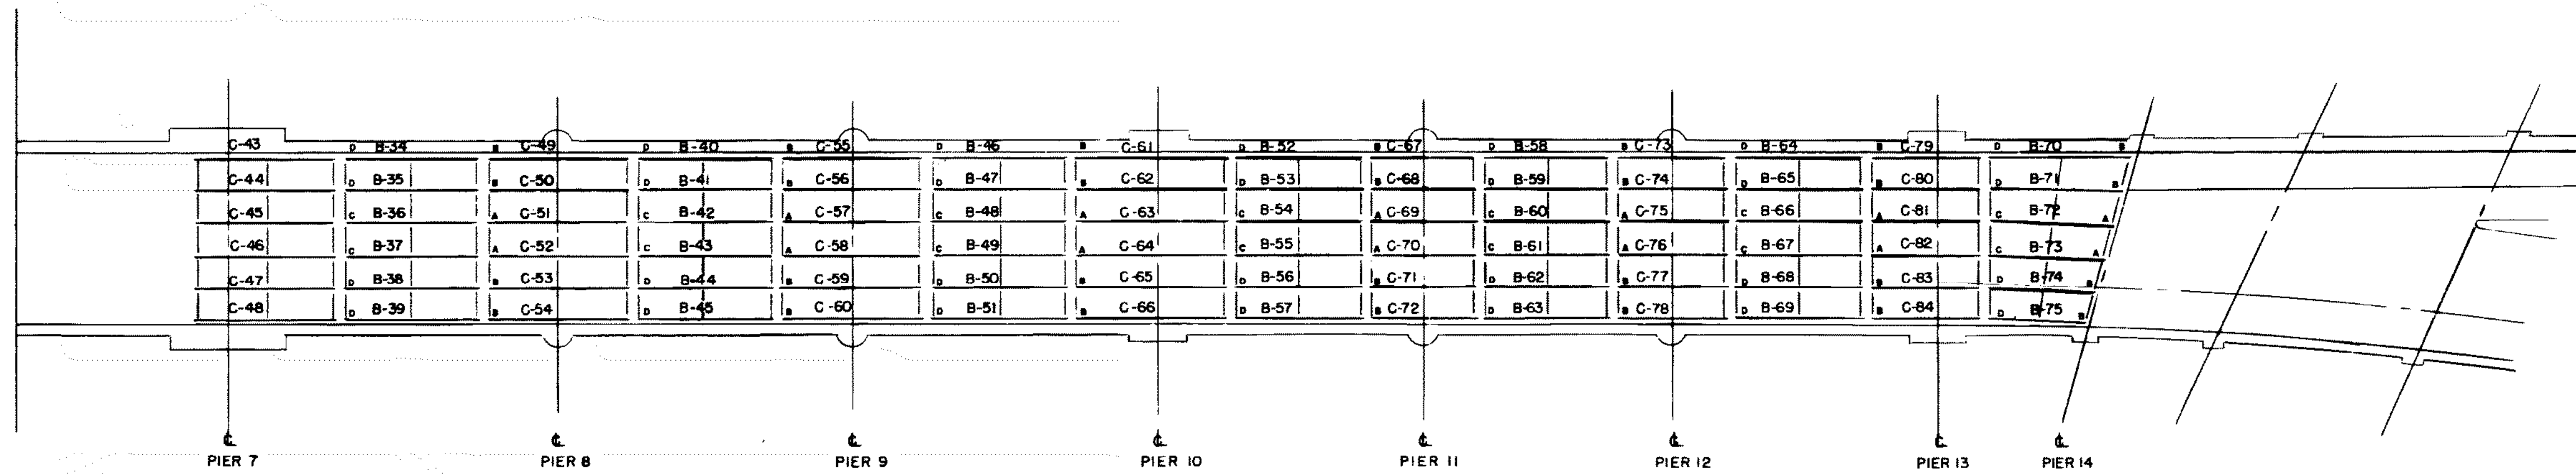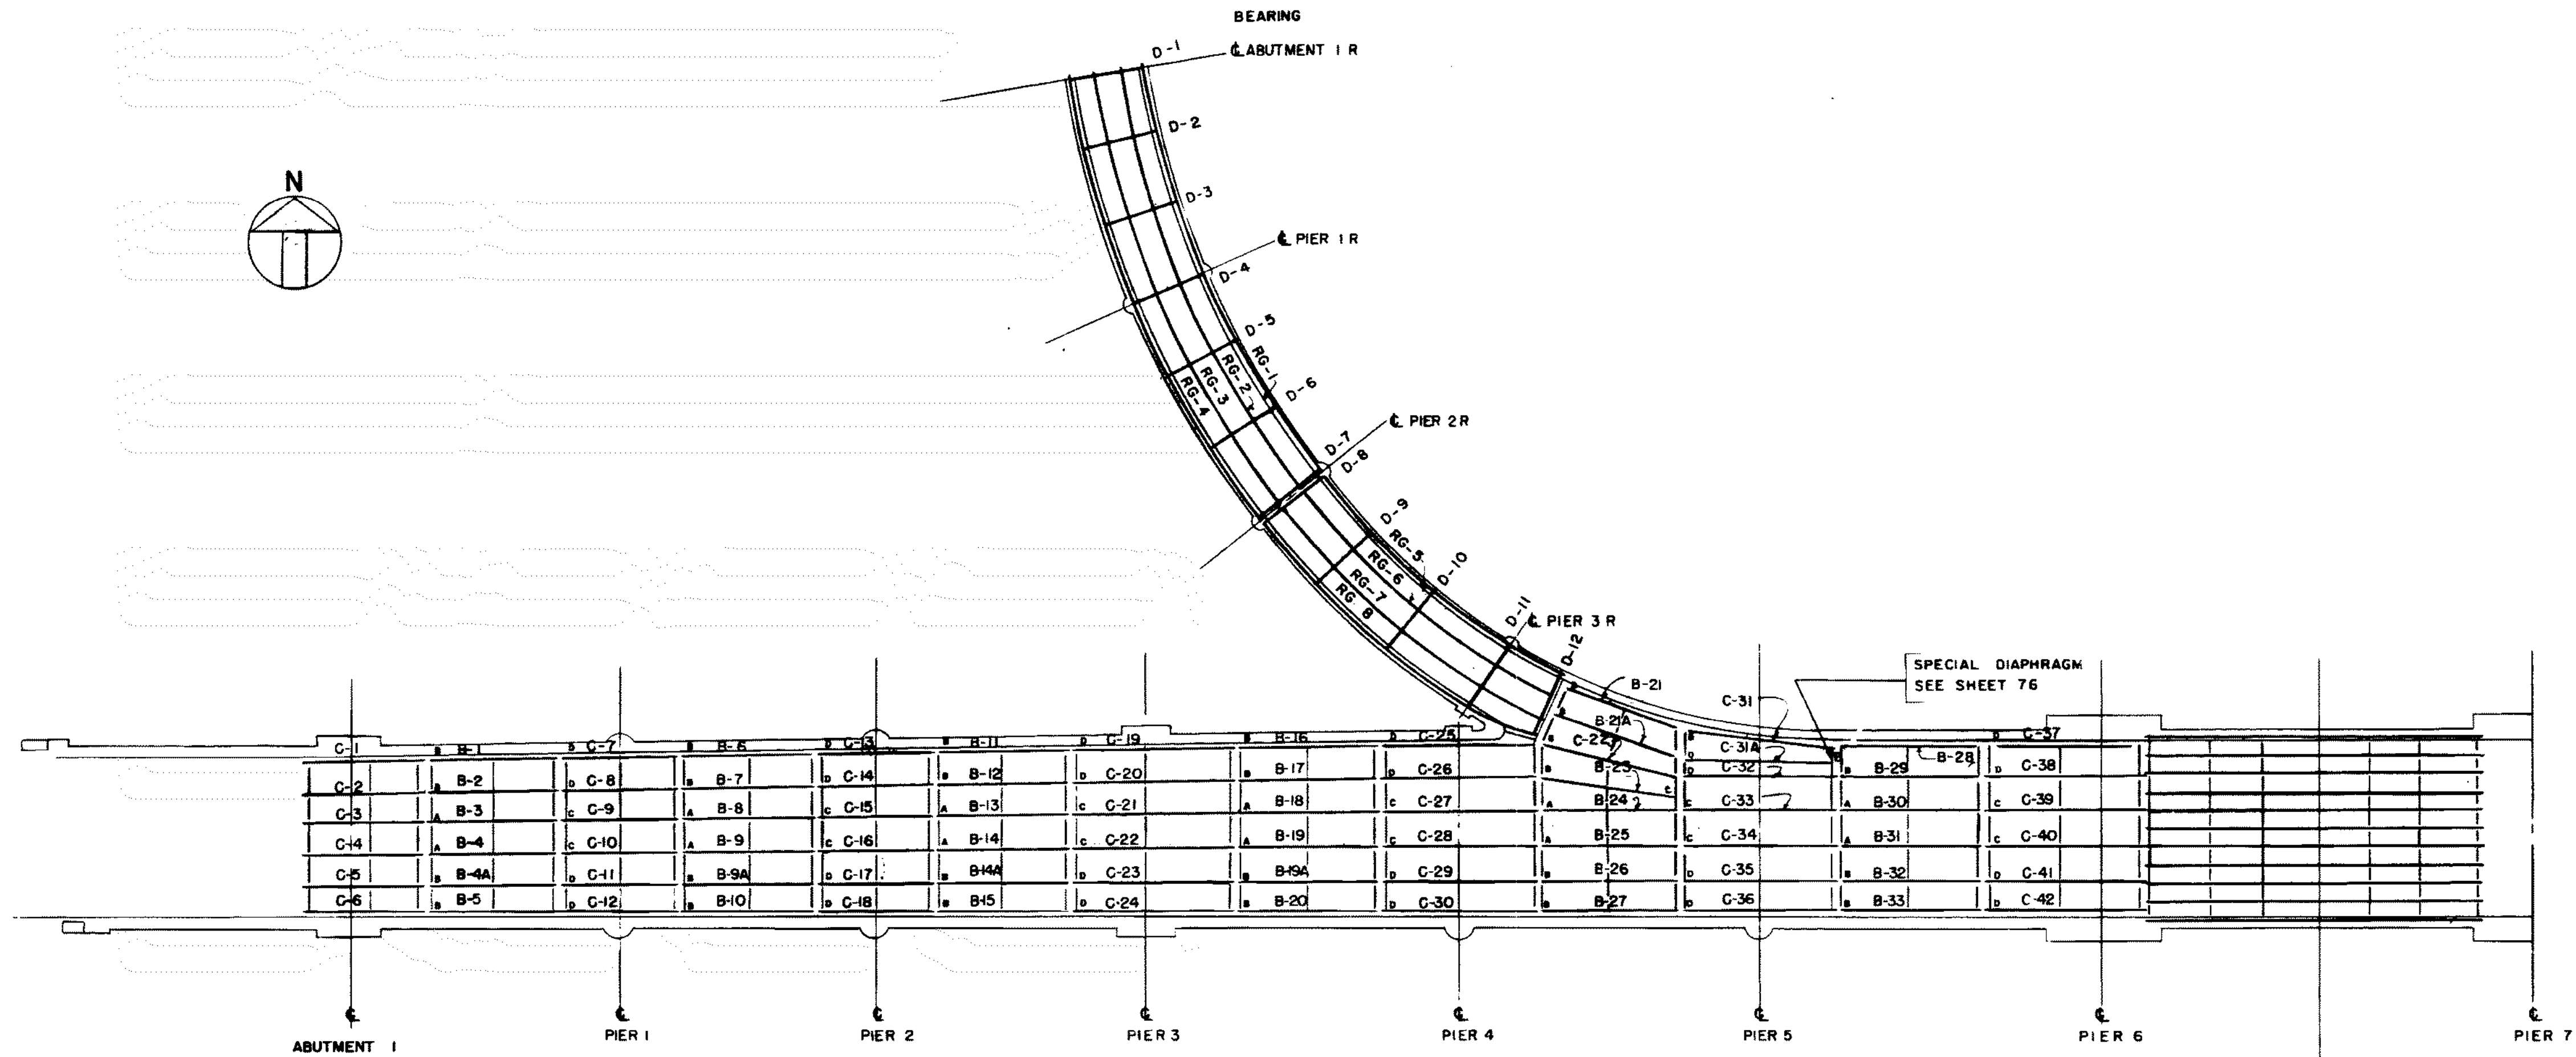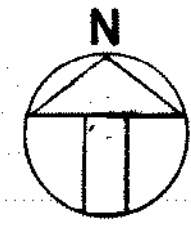

REFERENCES:  
 FOR MAIN SPAN STEEL SEE SHEETS 090 & 091.  
 FOR GRADES SEE SHEET 073.

**CONSTRUCTION LOADS**  
 MAXIMUM CONSTRUCTION LOAD 5 TONS  
 PER GIRDER, SEE GENERAL SPECIAL PROVISIONS  
 ON PAGES 6 - 1 3

**NOTES:**  
 A B B EXP. BEARINGS  
 C B O FIXED BEARINGS  
 SEE TABLE ON SHEET 075

| REVISIONS |      |    |
|-----------|------|----|
| NO.       | DATE | BY |
|           |      |    |
|           |      |    |
RHODE ISLAND  
 DEPARTMENT OF PUBLIC WORKS  
 DIVISION OF ROADS AND BRIDGES  
**WASHINGTON BRIDGE (NORTH)**  
 CROSSING SEEKONK RIVER  
 PROVIDENCE - EAST PROVIDENCE, RHODE ISLAND

**FRAMING PLAN**

**CHARLES A. MAGUIRE & ASSOCIATES**  
 ENGINEERS  
 PROVIDENCE, R. I. BOSTON, MASS.  
 DATE JAN 1967. DESIGNED BY  
 SCALE EXCEPT AS NOTED SHEET 70 OF 223

APPROVED \_\_\_\_\_ SET NO. \_\_\_\_\_  
 SUPERVISING CIVIL ENGINEER (BRIDGE) PRINTED  
 APPROVED \_\_\_\_\_  
 CHIEF ENGINEER ISSUED TO \_\_\_\_\_  
 FINAL DATE \_\_\_\_\_